


Section 19 Township 19 Range 9-W

Well No. #2 Link

Company Derby et al

NORTH Chase Pool

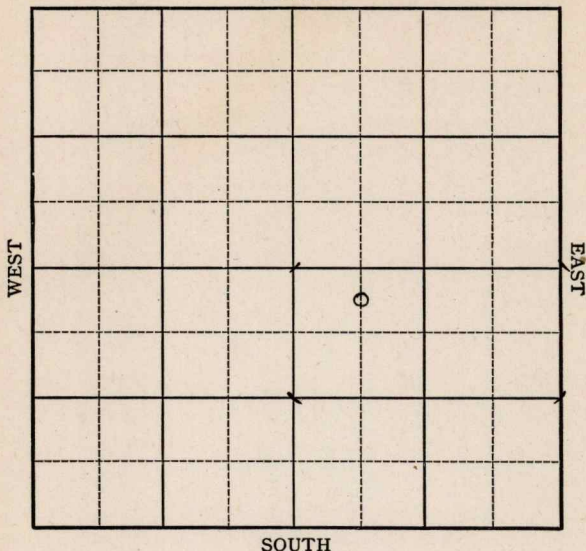

KANSAS

Rice

Sec. 19 Twp. 19 R. 9-WWell No. #2 Link FarmDerby et al Company

(Chase)


330 Ft. from N. Line

Ft. from S. Line

Ft. from E. Line

660 Ft. from W. Line

Elev. 1736

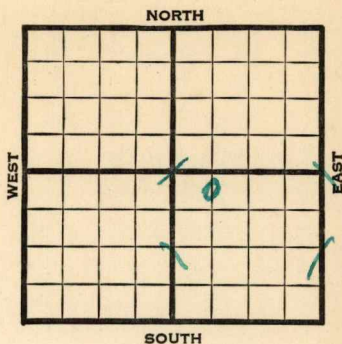

1941

REPORT

7/23

8" 200 Drlg. 980

7/31

Lans. 3021 Arb 3258 TD 3262'

Run 4"

8/7

Arb 3255' Corrected 4" @ 3257'

TD 3277' 100' oil 3 hrs.

8/13

Lans. 3021'

Arb. 3255'

4" - 3257'

T.D. 3285'

PB 3280'

Acid. 2000'

Phy Pot. 468 oil no water.

Grav. 42.6

COMPLETED

Map No. _____ Sec. 19 Twp. 19 R. 9WWell No. 2 Link

_____ Derby etal _____ Company

_____ Contractor

FIRST REPORT

SECTION PLAT

C N L NW SE


330 Ft. from N. Line

_____ Ft. from S. Line

_____ Ft. from E. Line

660 Ft. from W. Line

Chase Pool

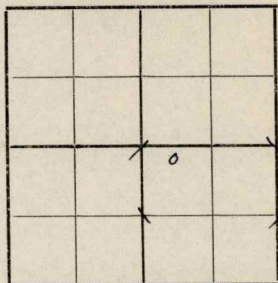

Location _____

Rig up _____

Drilling and Remarks:

8" - 200Drlg. 980

RECORD

Cased _____ in., _____ ft.

Sand _____

Gas _____

Oil _____

Total Depth _____

PRODUCTION

1st 24 hrs. Nat. _____

1st 24 hrs. after shot _____

Gas _____ Cu. Ft.

Dry Hole _____

Abandoned _____

Date

JUL 23 194119S. J. LEWIS

Scout

Map No. 49 Sec. 19 Twp. 19 R. 9WWell No. 2 Link

Derby etal

Company

Contractor


C N L NW SE

SECTION PLAT

330 Ft. from N. Line

Ft. from S. Line

Ft. from E. Line

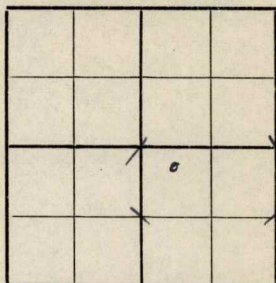660 Ft. from W. Line

CHASE POOL

Location

Rig up

Drilling and Remarks:

Lang 3021
 Arb 3255

4" 3257

P.B. 3280

2000 acid

shy Pot 468 oil no
 water

COMPLETED

RECORD

Cased _____ in., _____ ft.

Sand _____

Gas _____

Oil _____

Total Depth 3285

PRODUCTION

1st 24 hrs. Nat. _____

1st 24 hrs. after shot _____

Gas _____ Cu. Ft.

Dry Hole _____

Abandoned _____

Date

AUG 13 1941

19

S. J. LEWIS

Scout

426 grav