


Map No. KANSAS Sec. 3 Twp. 21 R. 3^w

Well No. 1 - Moore house Farm
Independent Company

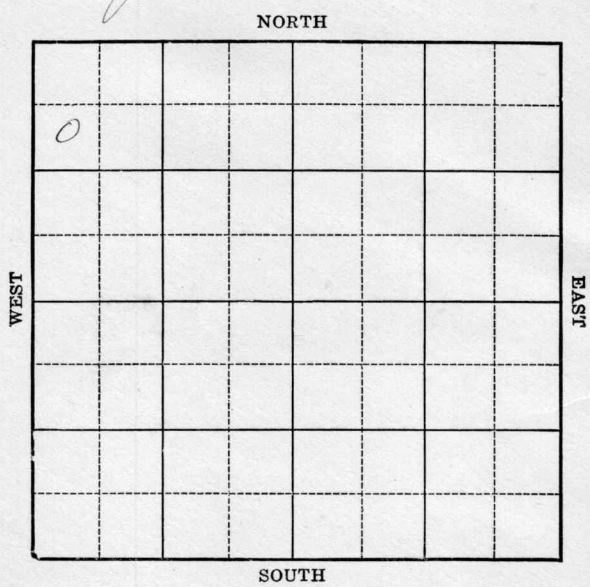

Location _____
Drilling Remarks _____

Rig Up _____
Drilling Remarks _____

RECORD

Cased _____ in. _____ ft.
Sand _____
Gas _____
Oil _____
Total Depth _____

PRODUCTION

1st 24 hrs. Nat. _____
1st 24 hrs. after shot _____
Gas _____ cu. ft.
Dry Hole _____
Abandoned _____

Map No. KANSAS Sec. 3 Twp. 21 R. 2W

Well No. 1 Stone house

Independent Oil & Gas Company

Contractor

SECTION PLAT

990 Ft. from N. Line

..... Ft. from S. Line

..... Ft. from E. Line

330 Ft. from W. Line

o			

FIRST REPORTS

Location.....

Rig up.....

Drilling and Remarks:

ROG

RECORD

Cased.....in.,ft.

Sand.....

Gas.....

Oil.....

Total Depth.....

PRODUCTION

1st 24 hrs. Nat.....

1st 24 hrs. after shot.....

Gas.....Cu. Ft.

Dry Hole.....

Abandoned.....

Date

APR 2 - 1930

192.....

S. J. LEWIS

Scout

Map No. **KANSAS** Sec. 3 Twp. 21 R. 3W

Well No. 1 Moorehouse

Independence Oil & Gas Company

Contractor

SECTION PLAT

990 Ft. from N. Line

..... Ft. from S. Line

..... Ft. from E. Line

330 Ft. from W. Line

6			

COMPLETED

Location.....

Rig up.....

Drilling and Remarks:

Wildcat 3395-3400

swath 1201 886

RECORD

Cased..... in., ft.

Sand.....

Gas.....

Oil.....

Total Depth 3405

PRODUCTION

1st 24 hrs. Nat.....

1st 24 hrs. after shot.....

Gas..... Cu. Ft.

Dry Hole.....

Abandoned.....

Date

MAY 14 1930

S. J. LEWIS Scout