


Map No. KANSAS Sec. 3 Twp. 21 R. 3<sup>w</sup>

Well No. 2 Morehouse Farm

C. W. Marland, Inc Company

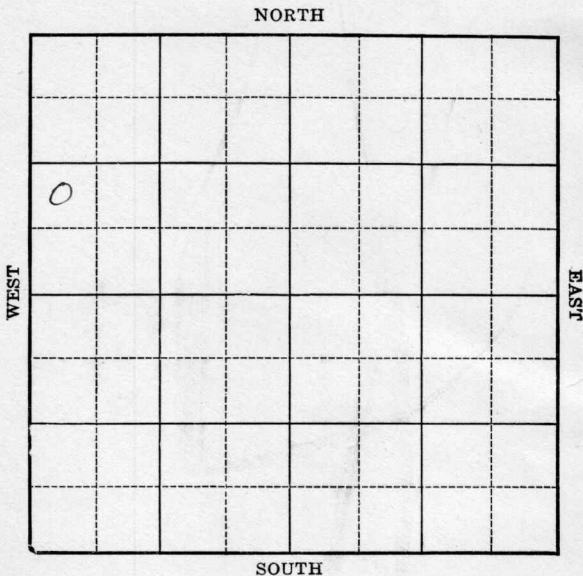

Location \_\_\_\_\_  
Drilling Remarks \_\_\_\_\_

Rig Up \_\_\_\_\_  
Drilling Remarks \_\_\_\_\_

\_\_\_\_\_  
\_\_\_\_\_  
**RECORD**

Cased \_\_\_\_\_ in. \_\_\_\_\_ ft.  
Sand \_\_\_\_\_  
Gas \_\_\_\_\_  
Oil \_\_\_\_\_  
Total Depth \_\_\_\_\_

**PRODUCTION**

1st 24 hrs. Nat. \_\_\_\_\_  
1st 24 hrs. after shot \_\_\_\_\_  
Gas \_\_\_\_\_ cu. ft.  
Dry Hole \_\_\_\_\_  
Abandoned \_\_\_\_\_

Map No. KANSAS Sec. 3 Twp. 21 R. 3<sup>w</sup>

Well No. 2-Moorehouse Farm  
C. H. Marland, Inc. Company

NORTH


\_\_\_\_\_ Ft. from N. Line

990 Ft. from S. Line

\_\_\_\_\_ Ft. from E. Line

330 Ft. from W. Line

1930

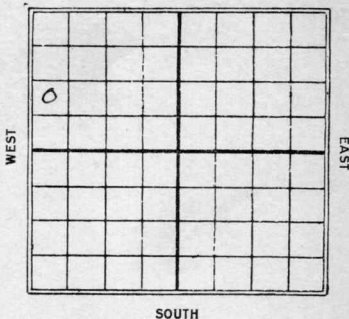

Date

REPORT

Date	REPORT
4/2	Rig
4/9	Rig
4/16	bltg 1758
4/23	" 2925
4/30	Top Shat 3019' Top Viola 3394' Rust
5/7	Wilcox 3409-18 Swab 794 bbls in 17 hrs.
5/14	Wilcox 3409-18' TD. 3418 swab 834 bbl oil Comp.

Map No. KANSAS Sec. 3 Twp. 21 R. 8W  
43

Well No. 2 Store house

E. W. Harland, Inc. Company

Contractor

SECTION PLAT

..... Ft. from N. Line

990 Ft. from S. Line

..... Ft. from E. Line

330 Ft. from W. Line

0			

FIRST REPORTS

Location.....

Rig up.....

Drilling and Remarks:

*ROG*

RECORD

Cased.....in., .....ft.

Sand.....

Gas.....

Oil.....

Total Depth.....

PRODUCTION

1st 24 hrs. Nat.....

1st 24 hrs. after shot.....

Gas.....Cu. Ft.

Dry Hole.....

Abandoned.....

Date

APR 2 - 1930

192.....

S. J. LEWIS

Scout

Map No. **KANSAS** Sec. 3 Twp. 21 R. 3W

Well No. 2 *Water house*

E. W. MacLanahan Inc. Company

Contractor

**SECTION PLAT**

0			

..... Ft. from N. Line

990 Ft. from S. Line

..... Ft. from E. Line

390 Ft. from W. Line

**COMPLETED**

Location.....

Rig up.....

Drilling and Remarks:

Willi 43409-18

1000 83484

**RECORD**

Cased..... in., ..... ft.

Sand.....

Gas.....

Oil.....

Total Depth 3418

**PRODUCTION**

1st 24 hrs. Nat.....

1st 24 hrs. after shot.....

Gas..... Cu. Ft.

Dry Hole.....

Abandoned.....

Date

MAY 14 1930

192.....

S. J. LEWIS

Scout