




*M<sup>o</sup> Pherson*

Map No. *1* **KANSAS** Sec. *4* Twp. *21* R. *3<sup>w</sup>*

Well No. *1- Kretzbill* Farm  
*W.C. M<sup>o</sup> Brice, Inc* Company

NORTH

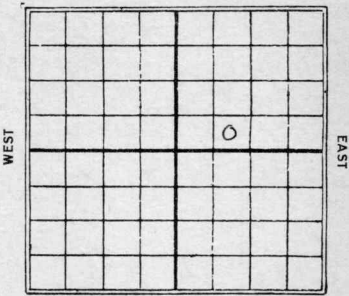

\_\_\_\_\_ Ft. from N. Line

*330* \_\_\_\_\_ Ft. from S. Line

\_\_\_\_\_ Ft. from E. Line

*990* \_\_\_\_\_ Ft. from W. Line

*1930*

Date	REPORT
<i>4/16</i>	<i>Rotary rig</i>
<i>4/23</i>	<i>Rigging up.</i>
<i>4/30</i>	<i>1st lg 7875'</i>
<i>5/7</i>	<i>" 2010'</i>
<i>5/14</i>	<i>" 2573'</i>
<i>5/21</i>	<i>Top Chat 2988</i> <i>8" 2989'</i>
<i>5/28</i>	<i>Log took 3008'</i>
<i>6/4</i>	<i>Estimated 2077</i> <i>gas 3050-71-</i> <i>hrlg ahead.</i>
<i>6/11</i>	<i>" 3180'</i>
<i>6/18</i>	<i>" 3278' Base</i> <i>Miss. 3100'</i>
<i>6/25</i>	<i>Clg. out 3278'</i>
<i>7/2</i>	<i>2nd lg. 3388-</i> <i>Base Viola-</i> <i>Tap Viola 3355</i>
<i>7/9</i>	<i>Mylcor 3395-3453</i> <i>Oil line 3465-75 TD</i> <i>Swab 460 bbl</i> <i>Comp.</i>

*W. Person*

Map No. KANSAS Sec. 4 Twp. 21 R. 3W

43  
Well No. 1 Mc Bride

W C Mc Bride Inc. Company

Contractor

SECTION PLAT

		0	

..... Ft. from N. Line

330 Ft. from S. Line

..... Ft. from E. Line

990 Ft. from W. Line

FIRST REPORTS

Location.....

Rig up.....

Drilling and Remarks:

*Rig Rotary*

RECORD

Cased.....in., .....ft.

Sand.....

Gas.....

Oil.....

Total Depth.....

PRODUCTION

1st 24 hrs. Nat.....

1st 24 hrs. after shot.....

Gas.....Cu. Ft.

Dry Hole.....

Abandoned.....

Date

APR 16 1930

S. J. LEWIS

Scout

Map No. *43* **KANSAS** Sec. *4* Twp. *21* R. *2W*

Well No. *1 Beech die*

*McCormick Bridge Inc.* Company

Contractor

**SECTION PLAT**

		0	

.....Ft. from N. Line

*830* Ft. from S. Line

.....Ft. from E. Line

*990* Ft. from W. Line

**COMPLETED**

**RECORD**

Location.....

Cased.....in., .....ft.

Rig up.....

Sand.....

Drilling and Remarks:

Gas.....

Oil.....

*Wilcox 3395-3403*

Total Depth *3470*

*Sil. 3465-70*

**PRODUCTION**

*swath 460x 8 1/2*

1st 24 hrs. Nat.....

1st 24 hrs. after shot.....

Gas.....Cu. Ft.

Dry Hole.....

Abandoned.....

Date

*JUL 9 1930*

*S. J. LEWIS*

Scout