


KANSAS

Rice county  
Chase Pool

Section 19 Township 19 Range 9W

Well No. 1 Proffit

Company C. H. Weaver etal

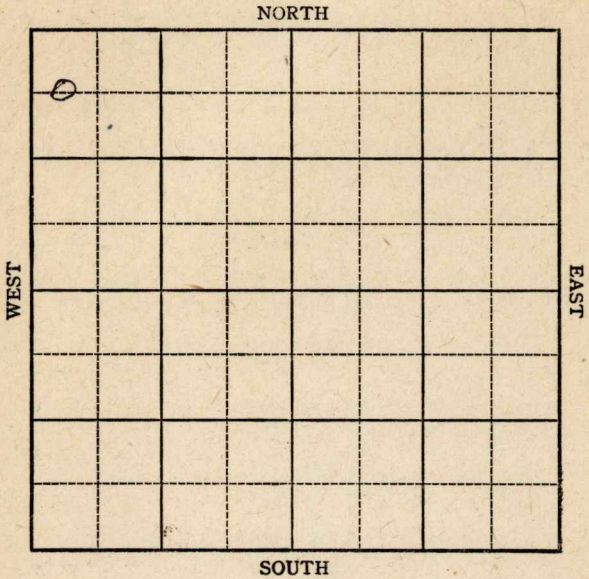




Sec. 19 Twp. 19 R. 9-W

Well No. #1 Proffit Farm  
C. H. Weaver et al Company  
Chase Pool

660 Ft. from N. Line  
         Ft. from S. Line  
         Ft. from E. Line  
330 Ft. from W. Line

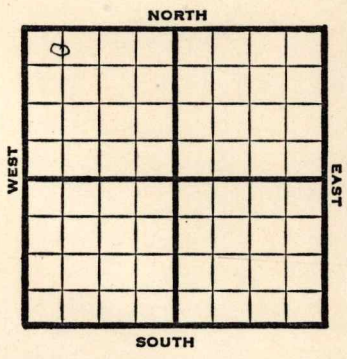

C W L NW NW

1947 **Elev. 17 39'** REPORT

4/16	Spud
4/23	8" @ 151' Drlg 2952'
4/29	<b>Lans 2931</b> <b>Arb 3267</b> TD 3277' 5" @ 3276' RUST
5/30	TD 3294' 1000 acid 1500' fluid
5/13	" "
5/20	" "
5/27	" "
6/3	" "
6/10	TD 3294'

OVER

6/18

Arb. 3267'

5" @ 3276'

1000 Acid

Pump 28 Oil and 19% W

41.6 Gr.

TD 3294'

**COMPLETED**

Map No. 1549 Sec. 19 Twp. 19 R. 9W

Well No. 1 Proffit

C. H. Weaver et al. Company

FIRST REPORT Contractor

C W L NW NW


SECTION PLAT

660 Ft. from N. Line

\_\_\_\_\_ Ft. from S. Line

\_\_\_\_\_ Ft. from E. Line

330 Ft. from W. Line

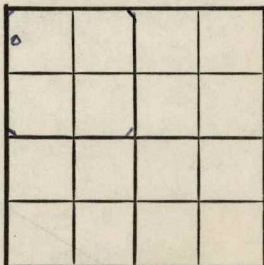

Rice County

Location \_\_\_\_\_

Rig up \_\_\_\_\_

Drilling and Remarks:

Spud

RECORD

Cased \_\_\_\_\_ in., \_\_\_\_\_ ft.

Sand \_\_\_\_\_

Gas \_\_\_\_\_

Oil \_\_\_\_\_

Total Depth \_\_\_\_\_

PRODUCTION

1st 24 hrs. Nat. \_\_\_\_\_

1st 24 hrs. after shot \_\_\_\_\_

Gas \_\_\_\_\_ Cu. Ft.

Dry Hole \_\_\_\_\_

Abandoned \_\_\_\_\_

Date

APR 16 1947

19

S. J. LEWIS Scout

Map No. 49 Sec. 19 Twp. 19 R. 9W

Well No. 1 Proffit

C. H. Weaver etal. Company

**COMPLETE**

Contractor

C W L NW NW

*E 11789*

**SECTION PLAT**

660 Ft. from N. Line

\_\_\_\_\_ Ft. from S. Line

\_\_\_\_\_ Ft. from E. Line

330 Ft. from W. Line

6			

Rice County

Location \_\_\_\_\_

Rig up \_\_\_\_\_

Drilling and Remarks:

*CR 8267*  
*5' 8276*  
*1000 feet*  
*Pump 28 oil +*  
*19 1/2 N.*  
*41 1/2 G*

**RECORD**

Cased \_\_\_\_\_ in., \_\_\_\_\_ ft.

Sand \_\_\_\_\_

Gas \_\_\_\_\_

Oil \_\_\_\_\_

Total Depth 3294

**PRODUCTION**

1st 24 hrs. Nat. \_\_\_\_\_

1st 24 hrs. after shot \_\_\_\_\_

Gas \_\_\_\_\_ Cu. Ft.

Dry Hole \_\_\_\_\_

Abandoned \_\_\_\_\_

Date

JUN 1 8 1947 19

S. J. LEWIS Scout