


Section 4 Township 21 Range 3W

Well No. #1 Krebiel

Company Brinrich Drlg. & Petrey

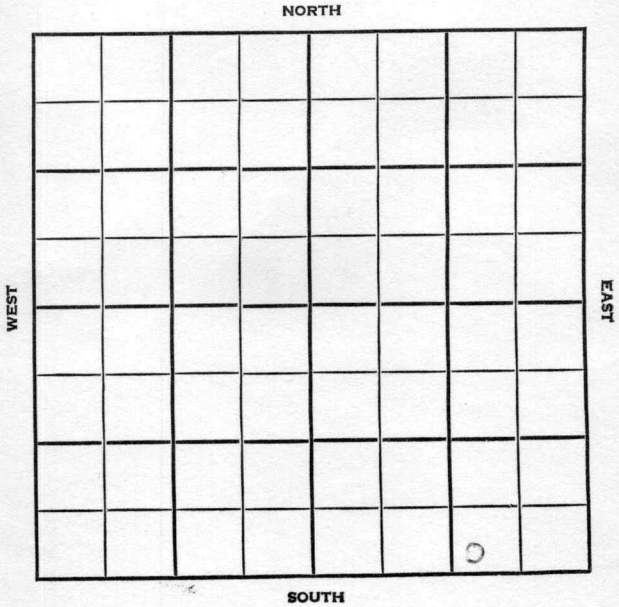

McPherson

KANSAS

SEC.	TWP.	R.
4	21	3W

WELL NO.

1 Krebiel

FARM

COMPANY

Brinrich Drlg & Petrey

CONTRACTOR

Co. Tools

Voshell


_____ Ft. from N. Line

_____ Ft. from S. Line

_____ Ft. from E. Line

_____ Ft. from W. Line

SW SE SE (Twin)

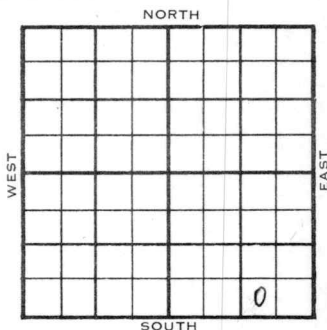

	ELEVATION	REPORT
1955	1449	

6/22

Comm 6-20-55
8" @ 255/200

7/20

Comm 6/20/55

M 2959

K 2988

Mz 3244

V 3254

S 3298

A 3364

TD 3420

8" @ 255 w/200

5 1/2" @ 3420

CO 3390 8/3368-70 FU 200' pil plus
2700' SW in 30" POP est Pmp

30 B0 plus 150 BWPD

COMPLETED

TOPS	DEPTH	LOG	DATUM	Loc. in Sec.
Anh.				SW SE SE
Tp.				
H.				
Tr.				
Dg.				
Bl.				
L.				Geol.
K.C.				Contr.
B.K.G.				Co. tools
Ce.				
C.				Pool
M.				Voshell
M.				
K.				
Mz.				
Mq.				
V.				
S.				
S.				
A.				
R.				
P.E.				
G.				
I.D.				

Lse.

No.

FIRST REPORT
JUN 22 1955

8" @ 255/200


County McPhersonElev. 1449Sec. 4Twp. 21SRge. 3WCompany Brinrich Drlg. & PetreyFarm Name KrebielNo. 1

TOPS	DEPTH	LOG	DATUM
Anh.			
TP.			
H.			
Tr.			
Dg.			
BL.			
L.			
K.C.			
B.K.C.			
Ce.			
C.			
M.	<u>2959</u>		<u>1510</u>
M.			
K.	<u>2988</u>		<u>1539</u>
Mz.	<u>3244</u>		
Mq.			
V.	<u>3254</u>		<u>1795</u>
S.	<u>3298</u>		<u>1849</u>
S.			
A.	<u>3364</u>		<u>1915</u>
R.			
PE.			
G.			
T.D.	<u>3420</u>		

Loc. in Sec. SW SE SE

(twin)

Geol. B. Brooks

Contr.

Pool

VoshellDate Comm. 6/20/55JUL 20 19558" 255 w/200 5 $\frac{1}{2}$ " 3420 CO 3390 8/3368-

70 FU 200' oil plus 2700' SW in 30"

POP est Pmp 30 BO plus 150 BWPD

SEC. 4 TWP. 21 S R. 3 W

WELL NO.

1 Krehbiel

FARM

COMPANY

Brenrich & Petrie

CONTRACTOR

Voshell


Ft. from N. Line

Ft. from S. Line

Ft. from E. Line

Ft. from W. Line

SW SE SE

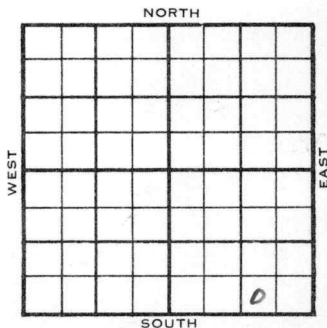

ELEVATION

REPORT

1955

O. W. P. B. NO-RECORD

8/10

Old Info: OTD 3420' 5" @ 3420
Was Arb. Prod.

NEW INFO: PB 3363. 16/3338-46.

No show; 20/3301-06; no show.

PB 3290'; 20/3270-75; 500 A,

Fill 400' oil, 75' wtr 8 hrs;

Swab 3 BOPH 4 hrs. POP

Pump 60 BOPD Grav 41.7°

Viola 3254' S. 3298' Arb. 3364'

FIRST REPORT
COMPLETED

O. W. P. B.

FORM 513 REV. SUNRAY

County McPherson Elev. _____
 Sec. 4 Twp. 21S Rge. 3W
 Company Brenrich & Petrie
 Farm Name Krehbiel No. 1

TOPS	DEPTH	LOG	DATUM	Loc. in Sec.
Anh.				SW SE SE
Tr.				
Dg.				
Bl.				
L.				Geol.
K.C.				Contr.
B.K.C.				
Ce.				
C.				
M.				
M.				Pool
K.				Voshell
Mz.				
Me.				
V.	3254			
S.	3298			
S.	3364			
A.				
R.				
Pf.				
G.				
T.D.				

NO-RECORD

FIRST REPORT
AUG 10 '35
COMPLETE

Date Comm. Old info - OTD 3420; 5" 3420; was
Arb. prod

New info - PB 3363; 16/3338-46; no show;
20/3301-06; no show; PB 3290; 20/3270-75

500 A; fill 400' oil 75' wtr 8 hrs.;

swb 3 boph 4 hrs.; POP; pmp 60 bopd grav.

41.70

8