


Rice

KANSAS

Section 19 Township 19 Range 9 W

Well No. # 5 Proffitt

Company C. H. Weaver

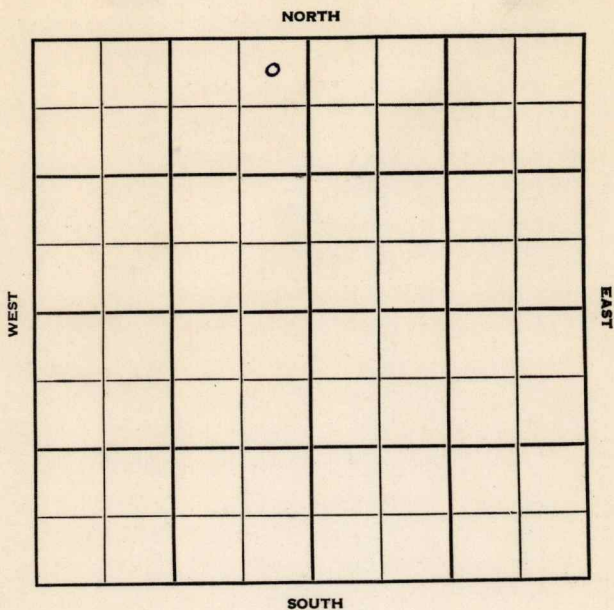

Rice

KANSAS

✓

Sec. 18 Twp. 19 R. 9W

Well No. #5 Proffitt Farm

C. H. Weaver Company

Gabbert & Jones Contractor

Chase Pool


330' Ft. from N. Line

Ft. from S. Line

330 Ft. from E. Line

330' Ft. from W. Line

NE NE NW

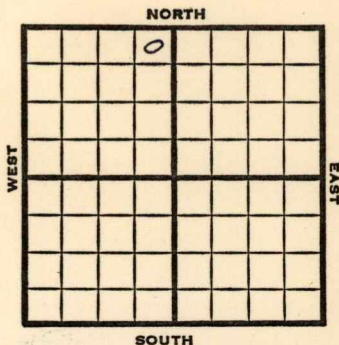

1951 Elev. 1737' REPORT

3/28 Location

5/9 Spud 3-29-51

Oil well TD 3285' 8" @ 140'

Heeb 2760' Br. line 2890', Lans. 2913'

SO 2993-3017', 3101-10', Cong. 3254',

Arb. 3273-77' 5" @ 3275' TD 3285'

FU 460' oil 12 hr. 500 A

S/2 BOPH

Comp. 40 BOPD

COMPLETED



Map No. \_\_\_\_\_ Sec. 19 Twp. 19 R. 9WWell No. 5 Proffitt\_\_\_\_\_C. H. Weaver\_\_\_\_\_  
Company\_\_\_\_\_  
Contractor

NE NE NW

## SECTION PLAT

330 Ft. from N. Line\_\_\_\_\_  
Ft. from S. Line330 Ft. from E. Line\_\_\_\_\_  
Ft. from W. Line

|  |  |   |  |
|--|--|---|--|
|  |  | 0 |  |
|  |  |   |  |
|  |  |   |  |
|  |  |   |  |

Rice County

Location \_\_\_\_\_

Rig up \_\_\_\_\_

Drilling and Remarks: \_\_\_\_\_

Reported

18-19-9W

## RECORD

Cased \_\_\_\_\_ in., \_\_\_\_\_ ft.

Sand \_\_\_\_\_

Gas \_\_\_\_\_

Oil \_\_\_\_\_

Total Depth \_\_\_\_\_

## PRODUCTION

1st 24 hrs. Nat. \_\_\_\_\_

1st 24 hrs. after shot \_\_\_\_\_

Gas \_\_\_\_\_ Cu. Ft.

Dry Hole \_\_\_\_\_

Abandoned \_\_\_\_\_

Date

APR 4 1951

19

J. E. TYRA Scout

County Rice State KansasSec. 18 (Blk. Twp.) 19 (Sur. Rge.) 9W Map No.Operator C. H. WeaverWell No. 5 Farm ProffittElev. Location NE NE NW

|  |  |   |  |  |  |
|--|--|---|--|--|--|
|  |  | 0 |  |  |  |
|  |  |   |  |  |  |
|  |  |   |  |  |  |
FIRST REPORT

330 Ft. From N Line NW330 Ft. From E Line Quarter1st. Report MAR 28 1951

Completion

Remarks

Gabbert & Jones - Contr.

Spudding Date

Drlg. Data Chase Pool

Location

See Correction

J. E. TYRA