




M<sup>o</sup> Okonon

Form 252A-5M-11-29-38055

Map No. KANSAS Sec. 4 Twp. 21 R. 3<sup>w</sup>

Well No. 2 Krebbil Farm  
W. C. M<sup>o</sup> Bride Company

NORTH

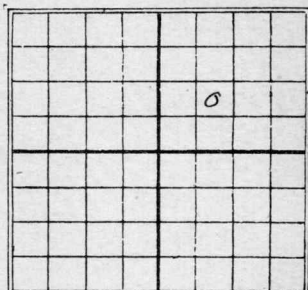

\_\_\_\_\_ Ft. from N. Line

990 Ft. from S. Line

\_\_\_\_\_ Ft. from E. Line

990 Ft. from W. Line

1930

Date

REPORT

Date	REPORT
4/16	Rig
4/23	185' of 15 1/2"
4/30	blkg. 1350'
5/7	" 2350'
5/14	" 3060' Top
	Shot 2977 show
	oil & gas 2990'
5/21	Top Viola 3370'
	T.D. 3376 Rust
5/28	
6/4	Slg. out - 3376'
6/11	Wilcox 3406-18'
	swab 592 bbls
	24 hrs.
6/18	Wilcox 3406-28
	TD 3428
	swab 592 bbl oil
	Comp.

*M. Pearson*

Map No. KANSAS Sec. 4 Twp. 21 R. 3 W  
43

Well No. 2 Ksekziel  
H. C. Mc Bride Company

Contractor

SECTION PLAT

..... Ft. from N. Line  
990 Ft. from S. Line  
 ..... Ft. from E. Line  
990 Ft. from W. Line

		o	

FIRST REPORTS

Location.....  
 Rig up.....  
 Drilling and Remarks:

*Rig Rotary*

RECORD

Cased..... in., ..... ft.  
 Sand.....  
 Gas.....  
 Oil.....  
 Total Depth.....

PRODUCTION

1st 24 hrs. Nat.....  
 1st 24 hrs. after shot.....  
 Gas..... Cu. Ft.  
 Dry Hole.....  
 Abandoned.....

Date  
APR 16 1930  
 192.....

S. J. LEWIS Scout

Map No. KANSAS Sec. 4 Twp. 21 R. 8W

43  
Well No. 2 Keeble

H. C. McBeck Inc Company

Contractor

SECTION PLAT

..... Ft. from N. Line

990 Ft. from S. Line

..... Ft. from E. Line

990 Ft. from W. Line


COMPLETED

Location.....

Rig up.....

Drilling and Remarks:

Wilcox 8406-28

swab 59288

RECORD

Cased..... in., ..... ft.

Sand.....

Gas.....

Oil.....

Total Depth 8428

PRODUCTION

1st 24 hrs. Nat.....

1st 24 hrs. after shot.....

Gas..... Cu. Ft.

Dry Hole.....

Abandoned.....

Date

JUN 18 1930 92

S. J. LEWIS Scout