


Map No. KANSAS Sec. 4 Twp. 21 R. 3^w

Well No. 2- Brehbil Farm
Barnsdall Oil Company

_____ Ft. from N. Line
330 Ft. from S. Line
_____ Ft. from E. Line
330 Ft. from W. Line

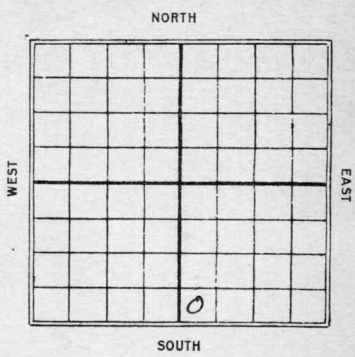

1930

Date	REPORT
<u>1/8</u>	<u>Bldy (rotary)</u>
<u>1/15</u>	<u>—</u>
<u>1/22</u>	<u>—</u>
<u>1/29</u>	<u>Rig</u>
<u>2/5</u>	<u>Drly 350</u>
<u>2/12</u>	<u>Trsq drly pipe 16 15'</u>
<u>2/19</u>	<u>Drly 2002</u>
<u>2/26</u>	<u>" 2815</u>
<u>3/5</u>	<u>Top Ghat 3010 T.D.</u> <u>3268 - Casing</u>
<u>3/12</u>	<u>Top Viola 3316 Base</u> <u>Viola 3345 T.D.</u> <u>3346 - Cement</u>
<u>3/19</u>	<u>Milcor 3367-70'</u> <u>T.D. 3370</u> <u>swab 1080 bbl</u> <u>Comp.</u>
<u>1930</u>	<u>OWDD</u>
<u>4/9</u>	<u>Sett line 3347-74</u> <u>103374</u> <u>1200 bbl oil</u> <u>Comp.</u>

W. Peterson
KANSAS

Map No. 43 Sec. 4 Twp. 21 R. 24

Well No. 2. Krehbiel

Barnsdall Oil Company

Contractor

SECTION PLAT

_____ Ft. from N. Line

380 Ft. from S. Line

_____ Ft. from E. Line

380 Ft. from W. Line

FIRST REPORTS

Location _____

Rig up _____

Drilling and Remarks:

*Building rig
Rotary*

RECORD

Cased _____ in., _____ ft.

Sand _____

Gas _____

Oil _____

Total Depth _____

PRODUCTION

1st 24 hrs. Nat. _____

1st 24 hrs. after shot _____

Gas _____ Cu. Ft.

Dry Hole _____

Abandoned _____

Date

JAN 8 1930
19

S. J. LEWIS Scout

Map No. **KANSAS** Sec. 4 Twp. 21 R. 2 W

Well No. 2 Keechiel

Barnwell Oil Company

Contractor

SECTION PLAT

.....Ft. from N. Line

320 Ft. from S. Line

.....Ft. from E. Line

320 Ft. from W. Line

COMPLETED

Location.....

Rig up.....

Drilling and Remarks:

Wilcox 3367-70

swath 1080 yds

RECORD

Cased.....in.,ft.

Sand.....

Gas.....

Oil.....

Total Depth 3270

PRODUCTION

1st 24 hrs. Nat.....

1st 24 hrs. after shot.....

Gas.....Cu. Ft.

Dry Hole.....

Abandoned.....

Date

MAR 19 1930

192.....

S. J. LEWIS Scout

Map No. **KANSAS** Sec. 4 Twp. 21 R. 3 W

Well No. 2 *Krehtiel*

Barnes Oil Company

Contractor

SECTION PLAT

Ft. from N. Line

320 Ft. from S. Line

Ft. from E. Line

320 Ft. from W. Line

FIRST REPORTS

COMPLETED

OW II

Location

Rig up

Drilling and Remarks:

Siliceous lime

3347-74

1200 ft.

RECORD

Cased.....in.,ft.

Sand.....

Gas.....

Oil.....

Total Depth 3374

PRODUCTION

1st 24 hrs. Nat.....

1st 24 hrs. after shot.....

Gas.....Cu. Ft.

Dry Hole.....

Abandoned.....

Date

APR 9 - 1930

192

S. J. LEWIS

Scout