


Map No. KANSAS Sec. 4 Twp. 21 R. 3^w

Well No. 3-Krehbil Farm
Barnsdall Company

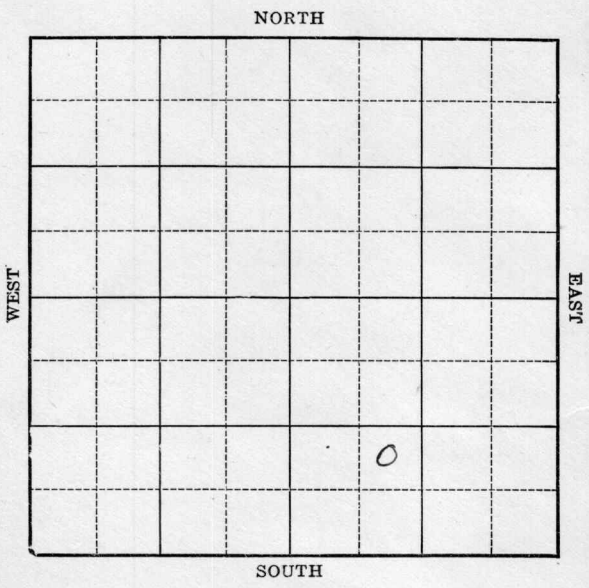

Location _____
Drilling Remarks _____

Rig Up _____
Drilling Remarks _____

RECORD

Cased _____ in. _____ ft.
Sand _____
Gas _____
Oil _____
Total Depth _____

PRODUCTION

1st 24 hrs. Nat. _____
1st 24 hrs. after shot _____
Gas _____ cu. ft. _____
Dry Hole _____
Abandoned _____

McPherson

Map No. KANSAS Sec. 4 Twp. 21 R. 3^w

Well No. 3 - Krehbil Farm
Barnsdall Oil Company


_____ Ft. from N. Line

990 Ft. from S. Line

_____ Ft. from E. Line

990 Ft. from W. Line

1930

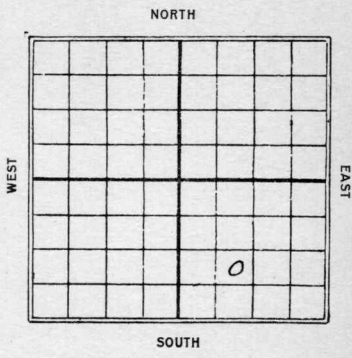

Date

REPORT

Date	REPORT
<u>4/9</u>	<u>Loc.</u>
<u>4/16</u>	<u>hdlg. 450'</u>
<u>4/23</u>	<u>" 2025'</u>
<u>4/30</u>	<u>" 2940'</u>
<u>5/7</u>	<u>Top Chat 2960-</u> <u>3255- 8" Rust</u>
<u>5/14</u>	<u>3255- hdlg. out</u> <u>plug</u>
<u>5/21</u>	<u>Mulcor 3301</u> <u>Silc lime 3361</u> <u>TD 3371</u> <u>swab 1145 bbl</u> <u>Cor. p.</u>

Map No. *M Nelson* **KANSAS** Sec. 4 Twp. 21 R. 34

Well No. 3 Freshfield

Barnwell Oil Company

Contractor

SECTION PLAT

..... Ft. from N. Line

990 Ft. from S. Line

..... Ft. from E. Line

990 Ft. from W. Line

COMPLETED

Location.....

Rig up.....

Drilling and Remarks:

Wilcox 3301
Silvino 3361
2 way 81145766

RECORD

Cased.....in.,ft.

Sand.....

Gas.....

Oil.....

Total Depth 3371

PRODUCTION

1st 24 hrs. Nat.....

1st 24 hrs. after shot.....

Gas.....Cu. Ft.

Dry Hole.....

Abandoned.....

Date

MAY 21 1930

192.....

S. J. LEWIS

Scout