


Map No. KANSAS Sec. 4 Twp. 21 R. 3^w
Well No. 3- Freshvil Farm
Pravie O & I Company

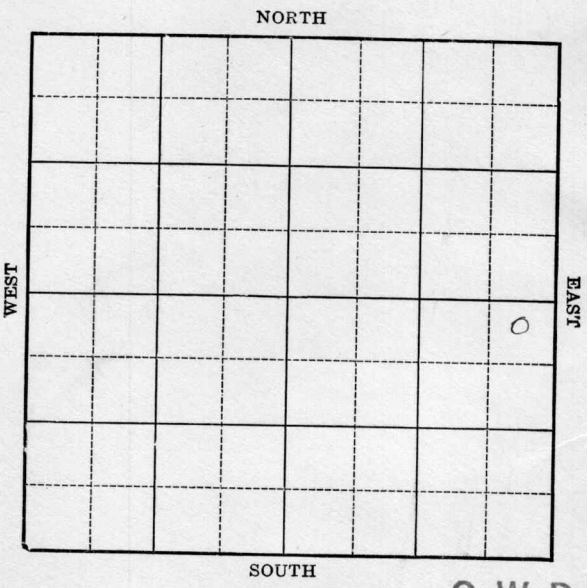

O. W. D. D

Location _____
Drilling Remarks _____

Rig Up _____
Drilling Remarks _____

RECORD


Cased _____ in. _____ ft.
Sand _____
Gas _____
Oil _____
Total Depth _____

PRODUCTION

1st 24 hrs. Nat. _____
1st 24 hrs. after shot _____
Gas _____ cu. ft. _____
Dry Hole _____
Abandoned _____

Map No. KANSAS Sec. 4 Twp. 21 R. 3^w
 Well No. 3- Krebbel Farm
Prarie O & G Company

225
~~330~~ Ft. from N. Line
 _____ Ft. from S. Line
260
~~330~~ Ft. from E. Line
 _____ Ft. from W. Line
1930

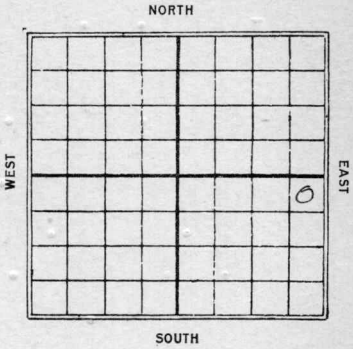

Date	REPORT	O. W. D. D
4/2	Bldg Rig	
4/9	Spud	
4/16	Krlg. 1810'	
4/23	" 2670'	
4/30	Top Shat 3012- 8" - Rust	
5/7	Slg. out 3012'	
5/14	Krlg 3085' 8M Gas 3013-35'	
5/21	Base Miss. line 3150' krlg. 3205'	
5/28	6" 3260' T.D. 3290' Fsq. failed.	
6/4	16" cemented 3365'	
6/11	Top Viola 3385' Mileor 3420-45' TD 3445'	
	Swab 350 bbl oil Comp.	

OVER

O. W. D. D

1936

11/10-Old T. D. 3455

Rigging up

11/19 Drlg. 3467'.

11/27 Wilcox 3480'. Drlg. 3489'.

12/3 Sil. 3480'. T. D. 3493'.

P. B. 3486 $\frac{1}{2}$ '. Swabbed 50 bbls
12 hours.

12/9 Sil. 3480

P.B. 3486 $\frac{1}{2}$

Pot. 60 oil 125 water

T.D. 3493

COMPLETED

Map No. **KANSAS** Sec. *4* Twp. *21* R. *2 W*

Well No. *43* **3 Keschel**

Prairie Oil Co. Company

Contractor

SECTION PLAT

225 Ft. from N. Line

..... Ft. from S. Line

260 Ft. from E. Line

..... Ft. from W. Line

			0

FIRST REPORTS

Location.....

Rig up.....

Drilling and Remarks:

Rotary Building rig

RECORD

Cased..... in., ft.

Sand.....

Gas.....

Oil.....

Total Depth.....

PRODUCTION

1st 24 hrs. Nat.....

1st 24 hrs. after shot.....

Gas..... Cu. Ft.

Dry Hole.....

Abandoned.....

Date

APR 2 - 1930
..... 192

S. J. LEWIS Scout

M. Peterson

Map No. **KANSAS** Sec. *4* Twp. *21* R. *SW*

Well No. *3 Ketchie C*

Prairie O & G Company

Contractor

SECTION PLAT

225 Ft. from N. Line

..... Ft. from S. Line

260 Ft. from E. Line

..... Ft. from W. Line

			<i>0</i>

COMPLETED

Location.....

Rig up.....

Drilling and Remarks:

Top Viola 3385

Wilcox 3420-45

Swab 3508 1/2

RECORD

Cased..... in., ft.

Sand.....

Gas.....

Oil.....

Total Depth *3445*

PRODUCTION

1st 24 hrs. Nat.....

1st 24 hrs. after shot.....

Gas..... Cu. Ft.

Dry Hole.....

Abandoned.....

Date

JUN 11 1930

192.....

S. J. LEWIS

Scout

Map No. 43 Sec. 4 Twp. 21 R. 8W.

Well No. 3 Krehbiel

Sinclair - Prairie Company

Contractor

SECTION PLAT

			o

225 Ft. from N. Line

_____ Ft. from S. Line

260 Ft. from E. Line

_____ Ft. from W. Line

FIRST REPORT

OWT II

Location _____

Rig up _____

Drilling and Remarks:

Old T II 3455

Rigging up

RECORD

Cased _____ in., _____ ft.

Sand _____

Gas _____

Oil _____

Total Depth _____

PRODUCTION

1st 24 hrs. Nat. _____

1st 24 hrs. after shot _____

Gas _____ Cu. Ft.

Dry Hole _____

Abandoned _____

Date

NOV 10 1936 19

S. J. LEWIS

Scout

Map No. 43 Sec. 4 Twp. 21 R. 3W

Well No. 3 Hesketh

Sinclair - Prairie Company

Contractor

SECTION PLAT

			o

225 Ft. from N. Line

_____ Ft. from S. Line

260 Ft. from E. Line

_____ Ft. from W. Line

COMPLETED

Location _____

Rig up _____

Drilling and Remarks:

*Sil 3480
P.B. 3486 1/2.
Port 60 oil
125 water*

RECORD

Cased _____ in., _____ ft.

Sand _____

Gas _____

Oil _____

Total Depth 3493

PRODUCTION

1st 24 hrs. Nat. _____

1st 24 hrs. after shot _____

Gas _____ Cu. Ft.

Dry Hole _____

Abandoned _____

Date

DEC 9 1936 19

S. J. LEWIS

Scout