


Map No. KANSAS Sec. 4 Twp. 21 R. 3^w

Well No. 4- Krehbil Farm
Barnsdall Oil Company

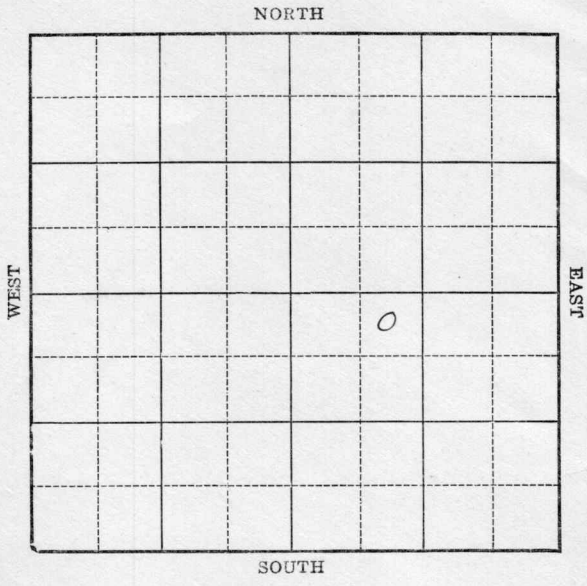

Location _____
Drilling Remarks _____

Rig Up _____
Drilling Remarks _____

RECORD


Cased _____ in. _____ ft.
Sand _____
Gas _____
Oil _____
Total Depth _____

PRODUCTION

1st 24 hrs. Nat. _____
1st 24 hrs. after shot _____
Gas _____ cu. ft.
Dry Hole _____
Abandoned _____

Map No. KANSAS Sec. 4 Twp. 21 R. 3^w
Well No. 4- Grekbil Farm
Barnsdall Oil Company

330 Ft. from N. Line
_____ Ft. from S. Line
_____ Ft. from E. Line
940 Ft. from W. Line
1930

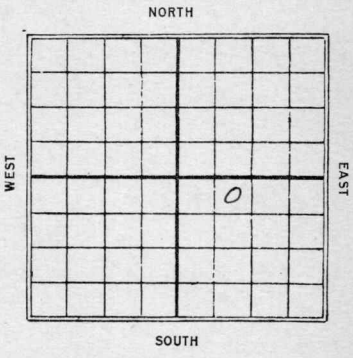

Date	REPORT
4/23	Run up
4/30	Delg. 1485'
5/7	" 2422'
5/14	" 2768'
5/21	2974 run 8"
5/28	Base Miss. 3065'
	Delg. 3285'
6/4	Malco 3371-91
	TD 3411
	Decline 3407-11
	swab 745 bbl oil
	Comp.

McNelson
KANSAS

Map No. 43 Sec. 4 Twp. 21 R. 2W

Well No. 4 Creek Hill

Barnsdall Oil Company

Contractor

SECTION PLAT

330 Ft. from N. Line

..... Ft. from S. Line

..... Ft. from E. Line

990 Ft. from W. Line

		o	

FIRST REPORTS

Location.....

Rig up.....

Drilling and Remarks:

Rigging up.
[Signature]

RECORD

Cased..... in., ft.

Sand.....

Gas.....

Oil.....

Total Depth.....

PRODUCTION

1st 24 hrs. Nat.....

1st 24 hrs. after shot.....

Gas..... Cu. Ft.

Dry Hole.....

Abandoned.....

Date

Map No. **KANSAS** Sec. 4 Twp. 21 R. 3W

43
Well No. 4 Kreschiel

Barnsdall Oil Company

Contractor

SECTION PLAT

320 Ft. from N. Line

..... Ft. from S. Line

..... Ft. from E. Line

990 Ft. from W. Line

		o	

COMPLETED

Location.....

Rig up.....

Drilling and Remarks:

Wilcox 3371-91

Oil lease 3407-11

100 x 8 7457 1/2

RECORD

Cased..... in., ft.

Sand.....

Gas.....

Oil.....

Total Depth 3711

PRODUCTION

1st 24 hrs. Nat.....

1st 24 hrs. after shot.....

Gas..... Cu. Ft.

Dry Hole.....

Abandoned.....

Date

JUN 4 1930₁₉₂

S. J. LEWIS Scout