


Section 19 Township 19 Range 9W

Well No. #5 Robbins

Company C. H. Weaver

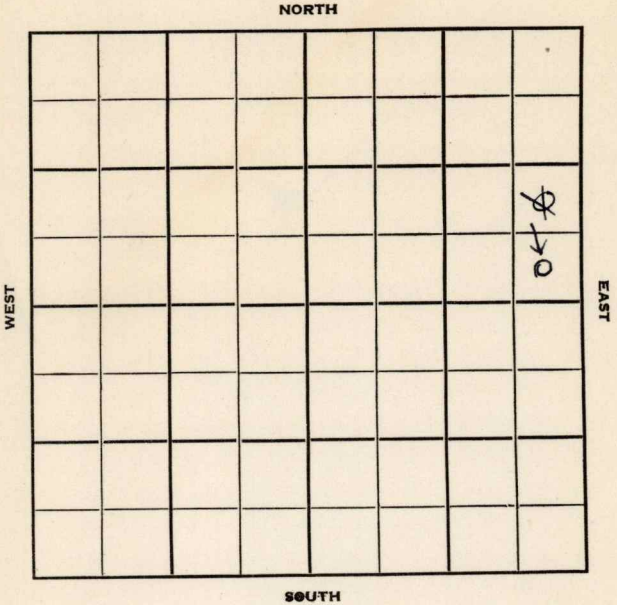

Rice KANSAS

Sec. 19 Twp. 19 R. 9 W ✓

Well No. # 5 Robbins Farm

C. H. Weaver Company

Gabbert & Jones Contractor

Chance

Ft. from N. Line

330

Ft. from S. Line

990


330

Ft. from E. Line

Ft. from W. Line

SE

NE SE NE

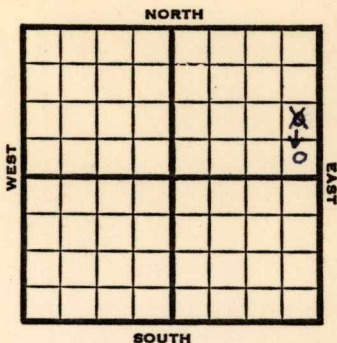

1951

Elev. 17328 REPORT


3/21

Spud 3-17-51
8" @ 170'
Drlg. 1200'

4/11

Spud 3-17-51
Oil Well TD 3248
8" @ 170 Heeb. 2752
Br Lime 2879 Lans. 2904
SO 2986-3012
DST 2984-95 opn ½ hr
Rec 108' oil 120' o & gcm
Arb. 3246 TD 3248
5" @ 3247 12/2979-83 FU 1200' oil
13 hr S/3 boph 300 A FU 2800'
oil 12 hr P/9 boph Comp. 100 bopd

COMPLETE

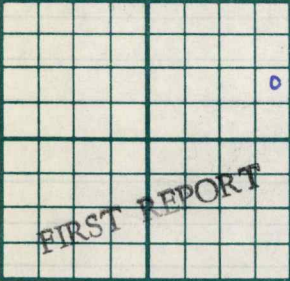County	Rice		State	Kansas	
Sec.	19	(Blk.) (Twp.)	19	(Sur.) (Rge.)	9W Map No.
Operator	C. H. Weaver				
Well No.	5	Farm	Robbins		
Elev.			Location	NE SE NE	
			990	Ft. From	S Line NE
			330	Ft. From	E Line Quarter
			1st. Report	MAR 21 1951	
			Completion		
			Remarks	Gabbert & Jones - Contr.	
Spudding Date	3-17-51				
Drlg. Data	Chase Pool				
8" @ 170			drlg. 1200		

J. E. TYRA

Kansas
KANSAS

Map No. _____ Sec. 19 Twp. 19 R. 9WWell No. 5 Robbins

C. H. Weaver _____ Company

~~CORRECTION~~ _____ Contractor


SE SE NE

SECTION PLAT

_____ Ft. from N. Line

330 Ft. from S. Line330 Ft. from E. Line

_____ Ft. from W. Line

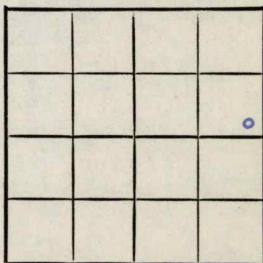Rice County

Location _____

Rig up _____

Drilling and Remarks:

Reported

NE SE NE

RECORD

Cased _____ in., _____ ft.

Sand _____

Gas _____

Oil _____

Total Depth _____

PRODUCTION

1st 24 hrs. Nat. _____

1st 24 hrs. after shot _____

Gas _____ Cu. Ft.

Dry Hole _____

Abandoned _____

Date

MAR 28 1951

19

J. E. TYRA

Scout

P/ 9 boph Comp. 100 bopd

J. E. TYRA