


*McPherson*

Map No. **KANSAS** Sec. 4 Twp. 21 R. 3<sup>w</sup>

Well No. 8 - McPherson Farm \_\_\_\_\_  
Prarie Oil Company \_\_\_\_\_

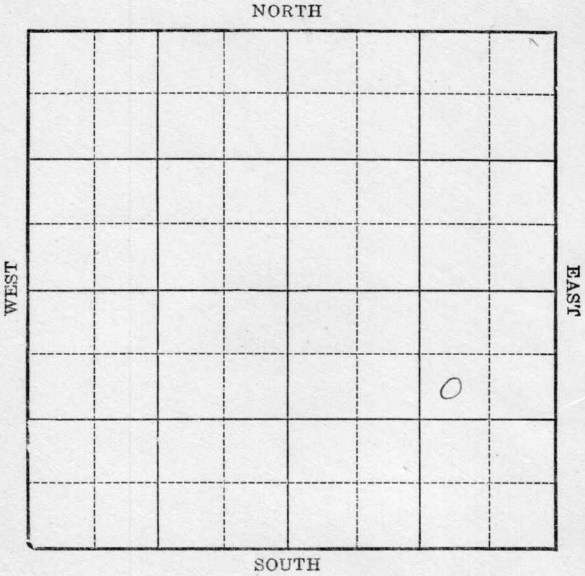

Location \_\_\_\_\_  
Drilling Remarks \_\_\_\_\_

Rig Up \_\_\_\_\_  
Drilling Remarks \_\_\_\_\_

\_\_\_\_\_  
\_\_\_\_\_  
**RECORD**


**PRODUCTION**

Cased \_\_\_\_\_ in. \_\_\_\_\_ ft.  
Sand \_\_\_\_\_  
Gas \_\_\_\_\_  
Oil \_\_\_\_\_  
Total Depth \_\_\_\_\_

1st 24 hrs. Nat. \_\_\_\_\_  
1st 24 hrs. after shot \_\_\_\_\_  
Gas \_\_\_\_\_ cu. ft.  
Dry Hole \_\_\_\_\_  
Abandoned \_\_\_\_\_

Map No. KANSAS Sec. 4 Twp. 21 R. 3<sup>w</sup>  
 Well No. 8 - Krebsbil Farm  
Prairie Oil & Company

990 Ft. from N. Line  
 \_\_\_\_\_ Ft. from S. Line  
990 Ft. from E. Line  
 \_\_\_\_\_ Ft. from W. Line

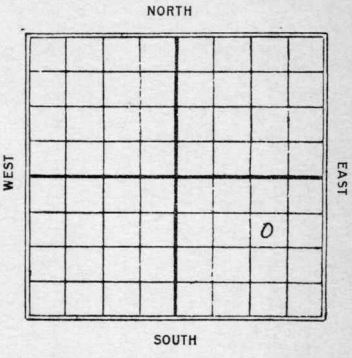

1930

Date	REPORT
4/23	Loc.
4/30	Rd.
5/7	Spud
5/14	15 1/2" - 182'
5/21	hrlg. 1600'
5/28	" 2850'
6/4	Top Chat 2985'
	Base Miss. Lime
	3070 - T.D. 3090 -
	rust
6/11	hrlg. 3275'
6/18	Top Viola 3293
	" Wilcox 3329
	" Selc line 3392
	swab 1000 bbl oil
	TD 3398'
	Pump.

Map No. 43 **KANSAS** Sec. 4 Twp. 21 R. 3 W

Well No. 8 Krechtel

Prairie Oil & Gas Company

Contractor

**SECTION PLAT**

990 Ft. from N. Line

..... Ft. from S. Line

990 Ft. from E. Line

..... Ft. from W. Line

			0

**FIRST REPORTS**

Location ✓

Rig up

Drilling and Remarks:

**RECORD**

Cased ..... in., ..... ft.

Sand

Gas

Oil

Total Depth

**PRODUCTION**

1st 24 hrs. Nat. ....

1st 24 hrs. after shot. ....

Gas ..... Cu. Ft.

Dry Hole

Abandoned

Date

..... 192 .....

**S. J. LEWIS**

Scout

Map No. KANSAS Sec. 4 Twp. 21 R. 3W

Well No. J. Kerschiel

Prairie Oil & G. Company

Contractor

SECTION PLAT


990 Ft. from N. Line

..... Ft. from S. Line

990 Ft. from E. Line

..... Ft. from W. Line

COMPLETED

RECORD

Location.....

Cased.....in., .....ft.

Rig up.....

Sand.....

Drilling and Remarks:

Gas.....

Viola 3293

Oil.....

Wilcox 3329

Total Depth 3398

Oil line 3392

swab 1000 ft

PRODUCTION

1st 24 hrs. Nat.....

1st 24 hrs. after shot.....

Gas.....Cu. Ft.

Dry Hole.....

Abandoned.....

Date

JUN 18 1930

S. J. LEWIS Scout