


Map No. KANSAS Sec. 4 Twp. 21 R. 3rd

Well No. 1 - Morehouse Farm
Clair O & G Company

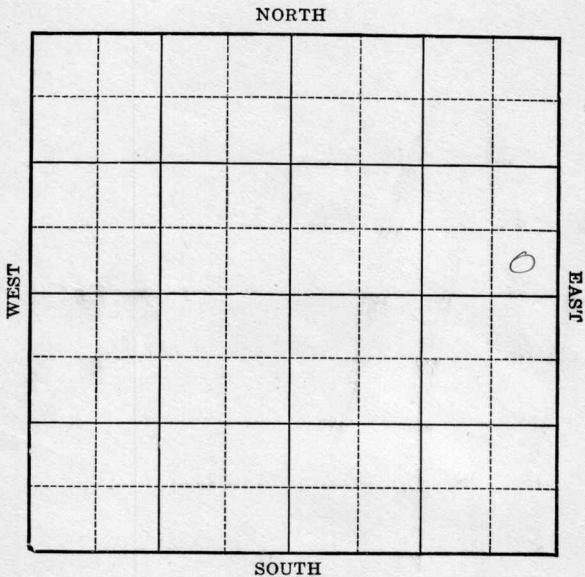

Location _____
Drilling Remarks _____

Rig Up _____
Drilling Remarks _____

RECORD

Cased _____ in. _____ ft.
Sand _____
Gas _____
Oil _____
Total Depth _____


PRODUCTION

1st 24 hrs. Nat. _____
1st 24 hrs. after shot _____
Gas _____ cu. ft. _____
Dry Hole _____
Abandoned _____

Map No. KANSAS Sec. 4 Twp. 21 R. 3^w

Well No. 1 - Moorehouse Farm
Sinclair Oil Company

_____ Ft. from N. Line
225
~~330~~ Ft. from S. Line
225
~~330~~ Ft. from E. Line
_____ Ft. from W. Line
1930

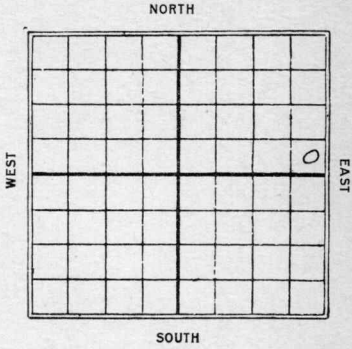

Date	REPORT
4/2	Reg (rotary)
4/9	2 1/2" 800'
4/16	" 2600'
4/23	" 3280' Chat 3000-3080'
4/30	Top Viola 3367 Cement 8"
5/7	Wilcox 3395-3410 Swab 842 bbls 24 hrs.
5/14	T.D. 3415' swab 395 - 9 hrs.
5/21	T.D. 3430' swab 919 bbls 24 hrs
5/28	Wilcox 3395-3430 swab 750 bbl oil Comp.

McPherson

Map No. **KANSAS** Sec. 4 Twp. 21 R. 3W
43

Well No. 1 Woodhouse

Sinclair Oil Co. Company

Contractor

SECTION PLAT

..... Ft. from N. Line

225 Ft. from S. Line

225 Ft. from E. Line

..... Ft. from W. Line

			o

FIRST REPORTS

Location.....

Rig up.....

Drilling and Remarks:

Rig Rotary

RECORD

Cased..... in., ft.

Sand.....

Gas.....

Oil.....

Total Depth.....

PRODUCTION

1st 24 hrs. Nat.....

1st 24 hrs. after shot.....

Gas..... Cu. Ft.

Dry Hole.....

Abandoned.....

Date

APR 2 - 1930

192

S. J. LEWIS

Scout

Map No. KANSAS Sec. 4 Twp. 21 R. 34W

Well No. 1 Moorehouse

Sinclair Oil Co. Company

Contractor

SECTION PLAT

..... Ft. from N. Line

225 Ft. from S. Line

225 Ft. from E. Line

..... Ft. from W. Line

COMPLETED

Location.....

Rig up.....

Drilling and Remarks:

Wilcox 3395-3430

swath 750 ft

RECORD

Cased..... in., ft.

Sand.....

Gas.....

Oil.....

Total Depth 3430

PRODUCTION

1st 24 hrs. Nat.....

1st 24 hrs. after shot.....

Gas..... Cu. Ft.

Dry Hole.....

Abandoned.....

Date

MAY 28 1930

S. J. LEWIS

Scout