


M^cPherson

Form 252A-5M-11-29-38055

Map No. KANSAS Sec. 4 Twp. 21 R. 3^w

Well No. 2 Moorehouse Farm
Senclair O & S Company

NORTH

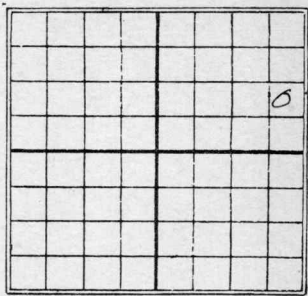

_____ Ft. from N. Line

990 Ft. from S. Line

330 Ft. from E. Line

_____ Ft. from W. Line

1930

Date

REPORT

O.W.D.D

4/2	Rig (rotary)
4/9	Spud
4/16	hdlg. 1860'
4/23	" 2970'
4/30	Top Chat 2996'
	Top Viola 3385-87
	Rust
5/7	Frq. bit 3420
5/14	Walcox 3378-91
	TD 3391' (5LM)
	Subs 917 bbl oil
	Comp.

1935

O.W.D.D

7/24	Oil 3508-12
	HFO 2 1/2 hrs
	Subst 8 bbls 1 hr
	20 bbls per hr for 20 hrs.
	400' water in hole.
7/31	Top Siliceous 3508
	T.D. 3512
	345 oil
	160 water

COMPLETED

Map No. *Mason* **KANSAS** Sec. *4* Twp. *21* R. *SW*

Well No. *43* *2 Moorehouse E*

Sinclair O & G Company

Contractor

SECTION PLAT

			o

Ft. from N. Line

990 Ft. from S. Line

320 Ft. from E. Line

Ft. from W. Line

FIRST REPORTS

Location

Rig up

Drilling and Remarks:

Rig Rotary

RECORD

Cased.....in.,ft.

Sand.....

Gas.....

Oil.....

Total Depth.....

PRODUCTION

1st 24 hrs. Nat.....

1st 24 hrs. after shot.....

Gas.....Cu. Ft.

Dry Hole.....

Abandoned.....

Date

APR 2 - 1930 *192*

S. J. LEWIS Scout

Map No. **KANSAS** Sec. 4 Twp. 21 R. 3W

Well No. 2 Warehouse

Sinclair Oil Co. Company

Contractor

SECTION PLAT

.....Ft. from N. Line

990 Ft. from S. Line

330 Ft. from E. Line

.....Ft. from W. Line

			o

COMPLETED

Location.....

Rig up.....

Drilling and Remarks:

Well log 3878-91
S. L. M.
swab 917 ft.

RECORD

Cased.....in.,ft.

Sand.....

Gas.....

Oil.....

Total Depth 3091

PRODUCTION

1st 24 hrs. Nat.....

1st 24 hrs. after shot.....

Gas.....Cu. Ft.

Dry Hole.....

Abandoned.....

Date

MAY 14 1930

192.....

S. J. LEWIS Scout

Map No. 43 Sec. 4 Twp. 21 R. 2W

Well No. 2 Woodhouse

Sinclair Prairie Company

Contractor

FIRST REPORTS

SECTION PLAT

..... Ft. from N. Line

990 Ft. from S. Line

380 Ft. from E. Line

..... Ft. from W. Line

			0

OWDD

Location.....

Rig up.....

Drilling and Remarks:

Oil 3508-12
HPD - 2 1/2 hr.
Swath 5 1/2 hr / hr
20 1/2 hr per hr for
20 hrs.
400' Water in hole.

RECORD

Cased..... in., ft.
 Sand.....
 Gas.....
 Oil.....
 Total Depth.....

PRODUCTION

1st 24 hrs. Nat.....
 1st 24 hrs. after shot.....
 Gas..... Cu. Ft.
 Dry Hole.....
 Abandoned.....

Date

7/27/35

192.....

ORVAL MANSCHRECK

Scout

Map No. 43 Sec. 4 Twp. 21 R. 3W

Well No. 2-Morehouse

Sinclair-prairie Company

Contractor

SECTION PLAT

			0

.....Ft. from N. Line

990 Ft. from S. Line

330 Ft. from E. Line

.....Ft. from W. Line

CCWSN

Location.....

Rig up.....

Drilling and Remarks:

345 oil
160 water

RECORD

Cased..... in.,ft.

Sand Sinclair 3508

Gas.....

Oil.....

Total Depth 3512

PRODUCTION

1st 24 hrs. Nat.....

1st 24 hrs. after shot.....

Gas..... Cu. Ft.

Dry Hole.....

Abandoned.....

Date

7-31-35 192.....

Scout

ORVAL MANNSCHRECK