


Map No. KANSAS Sec. 4 Twp. 21 R. 3<sup>w</sup>  
Well No. 3-Moorehouse Farm  
Dunclair Oil Company

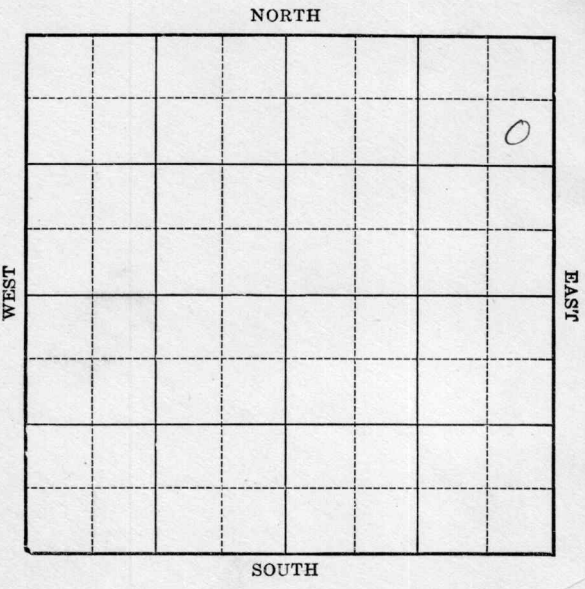

Location \_\_\_\_\_  
Drilling Remarks \_\_\_\_\_  
\_\_\_\_\_  
\_\_\_\_\_  
Rig Up \_\_\_\_\_  
Drilling Remarks \_\_\_\_\_  
\_\_\_\_\_  
\_\_\_\_\_  
**RECORD**

Cased \_\_\_\_\_ in. \_\_\_\_\_ ft.  
Sand \_\_\_\_\_  
Gas \_\_\_\_\_  
Oil \_\_\_\_\_  
Total Depth \_\_\_\_\_


**PRODUCTION**

1st 24 hrs. Nat. \_\_\_\_\_  
1st 24 hrs. after shot \_\_\_\_\_  
Gas \_\_\_\_\_ cu. ft.  
Dry Hole \_\_\_\_\_  
Abandoned \_\_\_\_\_

*McPherson*

Map No. KANSAS Sec. 4 Twp. 21 R. 3<sup>w</sup>  
 Well No. 3 - Moore house Farm  
Linclair Company

NORTH

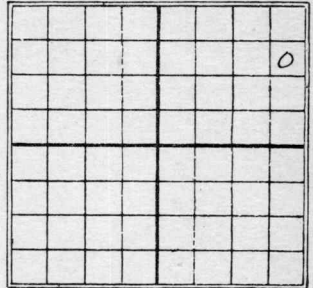

990 Ft. from N. Line

\_\_\_\_\_ Ft. from S. Line

330 Ft. from E. Line

\_\_\_\_\_ Ft. from W. Line

1930

Date

REPORT

Date	REPORT
4/9	Rig
4/16	hrlg 1125'
4/23	" 2570'
4/30	Top. Chat 2980-85 cement 8"
5/7	8 1/2 M gas 3015-40 hrlg 3115'
5/14	Top Viola 3312- hrlg 3323 270.
5/21	Wilcox 3360-71 T.D. 3395' swab 892 bbl 24 hrs
5/28	Wilcox 3360-95' TD 3395' swab 892 bbl oil Comp.

*M. Pearson*  
KANSAS

Map No. *43* Sec. *4* Twp. *21* R. *2W*

Well No. *3 Moore house*

*Sinclair Oil & Gas* Company

Contractor

SECTION PLAT

			0

*990* Ft. from N. Line

..... Ft. from S. Line

*330* Ft. from E. Line

..... Ft. from W. Line

FIRST REPORTS

Location.....

Rig up.....

Drilling and Remarks:

*Rotary  
Rig*

RECORD

Cased.....in., .....ft.

Sand.....

Gas.....

Oil.....

Total Depth.....

PRODUCTION

1st 24 hrs. Nat.....

1st 24 hrs. after shot.....

Gas.....Cu. Ft.

Dry Hole.....

Abandoned.....

Date

APR 9 - 1930 *192*

S. J. LEWIS Scout

Map No. KANSAS Sec. 4 Twp. 21 R. 3W

Well No. 3 Moore house

Sinclair O & G Company

Contractor

SECTION PLAT

990 Ft. from N. Line

..... Ft. from S. Line

3290 Ft. from E. Line

..... Ft. from W. Line

			0

COMPLETED

Location.....

Rig up.....

Drilling and Remarks:

Wilcox 3360 95

Sway 88 892 8 1/2

RECORD

Cased..... in., ..... ft.

Sand.....

Gas.....

Oil.....

Total Depth 3295

PRODUCTION

1st 24 hrs. Nat.....

1st 24 hrs. after shot.....

Gas..... Cu. Ft.

Dry Hole.....

Abandoned.....

Date

MAY 28 1930

S. J. LEWIS Scout