


M^o Pearson

Form 51-5M-2-29-34703

Map No. **KANSAS** Sec. *4* Twp. *21* R. *3w*

Well No. *4-Moorehouse* Farm
Lincoln Oil Company

NORTH

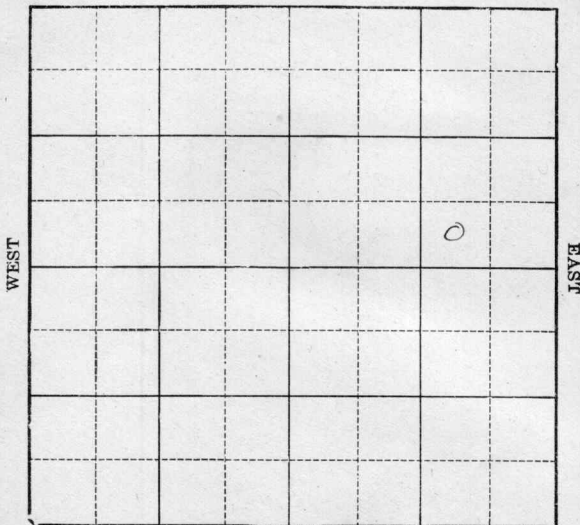

SOUTH

Location _____

Drilling Remarks _____

Rig Up _____

Drilling Remarks _____

RECORD

Cased _____ in. _____ ft.

Sand _____

Gas _____

Oil _____

Total Depth _____

PRODUCTION

1st 24 hrs. Nat. _____

1st 24 hrs. after shot _____


Gas _____ cu. ft.

Dry Hole _____

Abandoned _____

Map No. KANSAS Sec. 4 Twp. 21 R. 3^w
 Well No. H. J. Moore house Farm
Conclair Oil Company

_____ Ft. from N. Line
330 Ft. from S. Line
940 Ft. from E. Line
1930 Ft. from W. Line

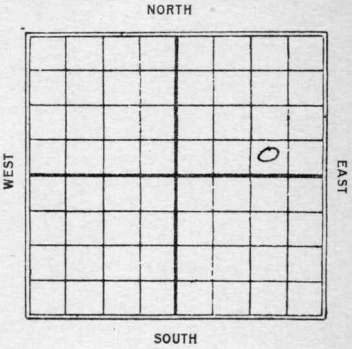

Date	REPORT
4/30	Bldg (rotary)
5/7	Rign up
5/14	Hblg. 1700'
5/21	" 2500'
5/28	" 3090' Top
	Chat 2995'
6/4	Top Viola 3334
	8" - Rust
6/11	Wilcox 3363-3410'
	TD 3410'
	swab 440 gal oil Comp.

Map No. KANSAS Sec. 4 Twp. 21 R. 3 W

Well No. 4 Moore house

Sinclair O & G. Company

Contractor

SECTION PLAT

.....Ft. from N. Line

380 Ft. from S. Line

990 Ft. from E. Line

.....Ft. from W. Line

FIRST REPORTS

Location.....

Rig up.....

Drilling and Remarks:

*Rotary
Bulldozing rig*

RECORD

Cased.....in.,ft.

Sand.....

Gas.....

Oil.....

Total Depth.....

PRODUCTION

1st 24 hrs. Nat.....

1st 24 hrs. after shot.....

Gas.....Cu. Ft.

Dry Hole.....

Abandoned.....

Date

APR 30 1930

S. J. LEWIS

Scout

Map No. *43* **KANSAS** Sec. *4* Twp. *21* R. *3W*

Well No. *4 Moorehouse*

Sinclair O & G. Company

Contractor

SECTION PLAT

..... Ft. from N. Line

320 Ft. from S. Line

990 Ft. from E. Line

..... Ft. from W. Line

			0

COMPLETED

Location.....

Rig up.....

Drilling and Remarks:

Wilcox 3363-3410

2 wa 884408 1/2

RECORD

Cased..... in., ft.

Sand.....

Gas.....

Oil.....

Total Depth *3410*

PRODUCTION

1st 24 hrs. Nat.....

1st 24 hrs. after shot.....

Gas..... Cu. Ft.

Dry Hole.....

Abandoned.....

Date

JUN 11 1930

192

S. J. LEWIS

Scout