


M^cPherson

Form 51-5M-2-29-34703

Map No. **KANSAS** Sec. *4* Twp. *21* R. *3^w*

Well No. *T-J Moore house* Farm
Senclair Oil & Gas Company

NORTH

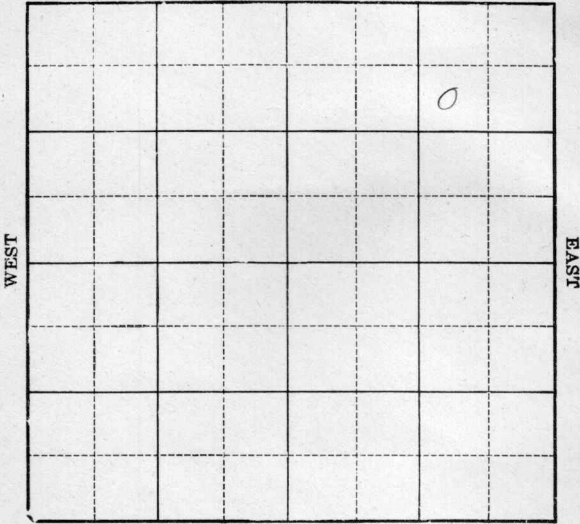

SOUTH

Location _____
Drilling Remarks _____

Rig Up _____
Drilling Remarks _____

RECORD

PRODUCTION

Cased _____ in. _____ ft.
Sand _____
Gas _____
Oil _____
Total Depth _____

1st 24 hrs. Nat. _____
1st 24 hrs. after shot _____
Gas _____ cu. ft. _____
Dry Hole _____
Abandoned _____

McPherson

Form 252A-5M-11-29-38055

Map No. KANSAS Sec. 4 Twp. 21 R. 3^w

Well No. 7-Moore house Farm
Sinclair Oil Company


990 Ft. from N. Line

Ft. from S. Line

990 Ft. from E. Line

Ft. from W. Line

1930

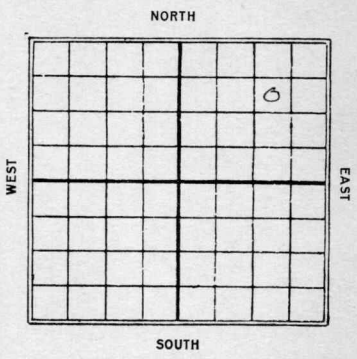

Date	REPORT
5/21	Loc.
5/28	Roll.
6/4	Rigging up
6/11	Hdg 930'
6/18	" 1250
6/25	" 2560'
7/2	" 3245'
7/9	Rust 3295'
7/16	Kilcox 3360-89
	TD 3389
	Swab 552 bbl oil
	Comp.

Map No. KANSAS Sec. 4 Twp. 21 R. 3W

Well No. 43 7 Wodehouse

Sinclair Oil & Gas Company

Contractor

SECTION PLAT

990 Ft. from N. Line

..... Ft. from S. Line

990 Ft. from E. Line

..... Ft. from W. Line

FIRST REPORTS

Location ✓

Rig up

Drilling and Remarks:

RECORD

Cased.....in.,ft.

Sand.....

Gas.....

Oil.....

Total Depth.....

PRODUCTION

1st 24 hrs. Nat.....

1st 24 hrs. after shot.....

Gas.....Cu. Ft.

Dry Hole.....

Abandoned.....

Date

MAY 21 1930

S. J. LEWIS Scout

Map No. KANSAS Sec. 4 Twp. 21 R. 3W

Well No. 7 Moores house

Sinclair Oil & Gas Company

Contractor

SECTION PLAT

			0

990 Ft. from N. Line

_____ Ft. from S. Line

990 Ft. from E. Line

_____ Ft. from W. Line

COMPLETED

Location _____

Rig up _____

Drilling and Remarks:

Wilcox 3360-89

11028855288

RECORD

Cased _____ in., _____ ft.

Sand _____

Gas _____

Oil _____

Total Depth 3389

PRODUCTION

1st 24 hrs. Nat. _____

1st 24 hrs. after shot _____

Gas _____ Cu. Ft.

Dry Hole _____

Abandoned _____

Date

JUL 16 1930

S. J. LEWIS

Scout