

M. O. Pherson

Map No. KANSAS Sec. 4 Twp. 21 R. 3rd

Well No. 9-Moorehouse Farm
Sinclair O&G Company


330 Ft. from N. Line

_____ Ft. from S. Line

990 Ft. from E. Line

_____ Ft. from W. Line

1930

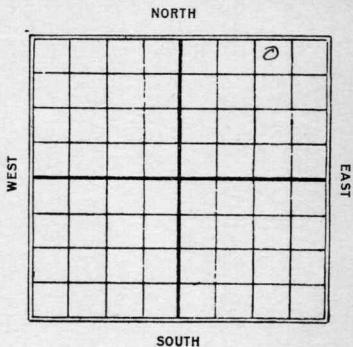

Date	REPORT
5/21	<i>Loc.</i>
5/28	<i>Bldg. rig.</i>
6/4	<i>Drillg. 480'</i>
6/11	<i>" 1970'</i>
6/18	<i>" 2300'</i>
6/25	<i>Rust 3227'</i>
7/2	<i>Base Miss 3155'</i>
	<i>Viola 3260'</i>
	<i>Drillg. 3262'</i>
7/9	<i>" 3317'</i>
	<i>1000' oil from Viola</i>
7/16	<i>Welded 3298-3305</i>
	<i>TD 3305</i>
	<i>swab 525 bbl oil Comp.</i>

M. Nelson

Map No. **KANSAS** Sec. 4 Twp. 21 R. 3W

Well No. 43 9. Moorehouse

Sinclair Oil & Gas Company

Contractor

SECTION PLAT

			0

330 Ft. from N. Line

..... Ft. from S. Line

990 Ft. from E. Line

..... Ft. from W. Line

FIRST REPORTS

Location ✓.....

Rig up.....

Drilling and Remarks:

RECORD

Cased..... in., ft.

Sand.....

Gas.....

Oil.....

Total Depth.....

PRODUCTION

1st 24 hrs. Nat.....

1st 24 hrs. after shot.....

Gas..... Cu. Ft.

Dry Hole.....

Abandoned.....

Date

MAY 21 1930 192.....

S. J. LEWIS

Scout

Map No. KANSAS Sec. 4 Twp. 21 R. 3W

Well No. 9 Modderhouse

Sinclair Oil & Gas Company

Contractor

SECTION PLAT

		<u>X/O</u>	

330 Ft. from N. Line

_____ Ft. from S. Line

990 Ft. from E. Line

_____ Ft. from W. Line

COMPLETED

Location _____

Rig up _____

Drilling and Remarks:

Wilcox 3295 3305

swabbed 25 yds

RECORD

Cased _____ in., _____ ft.

Sand _____

Gas _____

Oil _____

Total Depth 3305

PRODUCTION

1st 24 hrs. Nat. _____

1st 24 hrs. after shot _____

Gas _____ Cu. Ft.

Dry Hole _____

Abandoned _____

Date

JUL 16 1930

S. J. LEWIS

Scout