


Map No. KANSAS Sec. 4 Twp. 21 R. 3^w

Well No. 10-Moorehouse Farm
Senclair Oil Company

330 Ft. from N. Line
_____ Ft. from S. Line
_____ Ft. from E. Line
990 Ft. from W. Line
1930

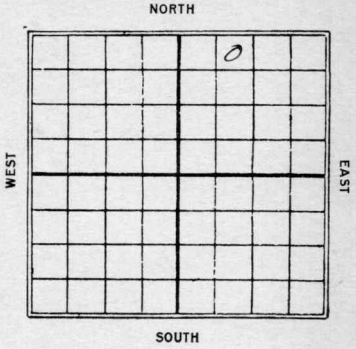

Date	REPORT
5/21	Loc
5/28	Rign up.
6/4	Hdg. 1475'
6/11	" 2365'
6/18	" 2700'
6/25	Rust 3210'
7/2	Top Viola 3236
	" Wilcox 3277-3305
	TD 3305
	Swab 1365 bbl oil
	Comp.
1931	OWDID
6/3	Old TD 3305
	R.U. to deepen
6/10	Top Chic lime 3341
	TD 3351
	400 bbl before deepening
	swab 660 bbl after
	deepening - some water
6/17	TD 3351
	swab 250 bbls oil
	& 300 bbl water
6/24	_____

7/1- TD. 3351' shut in

7/8- 107 bbls 11 hrs.

7/15

7/22. Silic lime 3341-51
TD. 3351

Made 202 bbl oil
and 40 " water
in 24 hrs.

Comp.

Map No. KANSAS Sec. 4 Twp. 21 R. 21 W

Well No. 43
10 Water house

Sinclair Oil & Gas Company

Contractor

SECTION PLAT

		0	

300 Ft. from N. Line

..... Ft. from S. Line

..... Ft. from E. Line

990 Ft. from W. Line

FIRST REPORTS

Location.....

Rig up.....

Drilling and Remarks:

RECORD

Cased..... in., ft.

Sand.....

Gas.....

Oil.....

Total Depth.....

PRODUCTION

1st 24 hrs. Nat.....

1st 24 hrs. after shot.....

Gas..... Cu. Ft.

Dry Hole.....

Abandoned.....

Date

MAY 21 1930

S. J. LEWIS Scout

Map No. KANSAS Sec. 4 Twp. 21 R. 24

Well No. 10 Moorehouse

Sinclair Oil Co. Company

Contractor

SECTION PLAT

		0	

330 Ft. from N. Line

_____ Ft. from S. Line

_____ Ft. from E. Line

990 Ft. from W. Line

COMPLETED

Location _____

Rig up _____

Drilling and Remarks:

Viola 3286
Wilcox 3297-3305
210288 1365886

RECORD

Cased _____ in., _____ ft.

Sand _____

Gas _____

Oil _____

Total Depth 9305

PRODUCTION

1st 24 hrs. Nat. _____

1st 24 hrs. after shot _____

Gas _____ Cu. Ft.

Dry Hole _____

Abandoned _____

Date

JUL 2 1939

S. J. LEWIS Scout

McPherson

Map No. Sec. 4 Twp. 21 R. 3^W

Well No. 43 10 *warehouse*

Sinclair Oil & Gas Co. Company

Contractor

FIRST REPORTS

SECTION PLAT

330 Ft. from N. Line

..... Ft. from S. Line

..... Ft. from E. Line

990 Ft. from W. Line

		0	

"ole well deeper"

Location.....

Rig up *ole JD 3305*

Drilling and Remarks:

*Rigging up to
deeper.*

RECORD

Cased..... in., ft.

Sand.....

Gas.....

Oil.....

Total Depth.....

PRODUCTION

1st 24 hrs. Nat.....

1st 24 hrs. after shot.....

Gas..... Cu. Ft.

Dry Hole.....

Abandoned.....

Date
JUN 3 1931

192 **CHAS. L. SHERWOOD** Scout

Mepherston

Map No. KANSAS Sec. 4 Twp. 21 R. 3^w

Well No. 43 10 *McDonhouse*

Sinclair Oil & Gas Co. Company

Contractor

COMPLETE

SECTION PLAT

330 Ft. from N. Line

..... Ft. from S. Line

..... Ft. from E. Line

990 Ft. from W. Line

		o	

Location.....

Rig up.....

Drilling and Remarks:

*202 Bls Oil
40 " Water
24 hours.*

RECORD

Cased..... in., ft.

Sand *Sili 3341-51*

Gas.....

Oil.....

Total Depth 3351

PRODUCTION

1st 24 hrs. Nat.....

1st 24 hrs. after shot.....

Gas..... Cu. Ft.

Dry Hole.....

Abandoned.....

Date

JUL 22 1931

192

CHAS. L. SHERWOOD

Scout