

McPherson

Map No. KANSAS Sec. 4 Twp. 21 R. 3^w

Well No. 6 - Krebil Farm
Prairie O & G Company


_____ Ft. from N. Line

880 Ft. from S. Line

_____ Ft. from E. Line

990 Ft. from W. Line

1930

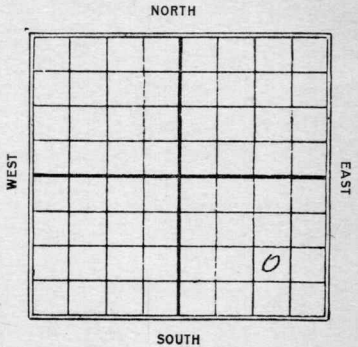

Date

REPORT

| Date | REPORT |
|-------------|--|
| <u>4/9</u> | <u>Ruck</u> |
| <u>4/16</u> | <u>_____</u> |
| <u>4/23</u> | <u>Utlg. 1280'</u> |
| <u>4/30</u> | <u>" 1750'</u> |
| <u>5/7</u> | <u>" 2725'</u> |
| <u>5/14</u> | <u>Top Shot 2955'</u> <u>Ruck</u> |
| <u>5/21</u> | <u>Utlg. 3250 1000'</u> <u>oil in hole - show</u> <u>gas. 2965'</u> |
| <u>5/28</u> | <u>Viola 3270</u> <u>Wilcox 3303-69'</u> <u>TD 3369</u> <u>swab 725 bbl oil</u> <u>Comp.</u> |

Map No. **KANSAS** Sec. 4 Twp. 21 R. 8 W

Well No. 6 Krehbiel

Prairie Oil & Gas Company

Contractor

SECTION PLAT

| | | | |
|--|--|--|---|
| | | | |
| | | | |
| | | | |
| | | | 0 |

..... Ft. from N. Line

880 Ft. from S. Line

..... Ft. from E. Line

990 Ft. from W. Line

FIRST REPORTS

Location.....

Rig up.....

Drilling and Remarks:

*Rotary
Rigging up*

RECORD

Cased..... in., ft.

Sand.....

Gas.....

Oil.....

Total Depth.....

PRODUCTION

1st 24 hrs. Nat.....

1st 24 hrs. after shot.....

Gas..... Cu. Ft.

Dry Hole.....

Abandoned.....

Date

APR 9 - 1930

192

S. J. LEWIS Scout

Map No. **KANSAS** Sec. 4 Twp. 21 R. 21W

Well No. 6 Kriebitz

Prairie O & G. Company

Contractor

SECTION PLAT

..... Ft. from N. Line

880 Ft. from S. Line

..... Ft. from E. Line

990 Ft. from W. Line

| | | | |
|--|--|--|---|
| | | | |
| | | | |
| | | | |
| | | | |
| | | | o |

COMPLETED

Location.....

Rig up.....

Drilling and Remarks:

Viola 3270
Wilcox 3303-69
swab 725 ft

RECORD

Cased..... in., ft.

Sand.....

Gas.....

Oil.....

Total Depth 3269

PRODUCTION

1st 24 hrs. Nat.....

1st 24 hrs. after shot.....

Gas..... Cu. Ft.

Dry Hole.....

Abandoned.....

Date

MAY 28 192

S. J. LEWIS Scout