




McPherson

Form 252A-5M-11-29-38055

Map No. KANSAS Sec. 4 Twp. 21 R. 3<sup>w</sup>

Well No. 6-Moorehouse Farm  
Linclair Oil Company

NORTH

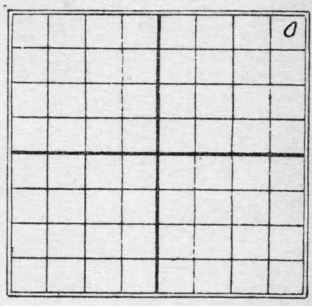

330 Ft. from N. Line

..... Ft. from S. Line

330 Ft. from E. Line

..... Ft. from W. Line

1930

Date

REPORT

5/14	ROB (rotary)
5/21	Bldg rig
5/28	hrlg. 1060'
6/4	" 2600'
6/11	Top. Shat 2976'
	hrlg 3040'
6/18	" 3110'
6/25	Wileox 3330-64
	TD 3364
	swab 900 gal oil
	Comp.

Map No. KANSAS Sec. 4 Twp. 21 R. 8W

Well No. 6 Moderehouse

Beclair O & G Company

Contractor

SECTION PLAT

380 Ft. from N. Line

..... Ft. from S. Line

380 Ft. from E. Line

..... Ft. from W. Line

			0

FIRST REPORTS

Location.....

Rig up.....

Drilling and Remarks:

ROG  
Rotary

RECORD

Cased.....in., .....ft.

Sand.....

Gas.....

Oil.....

Total Depth.....

PRODUCTION

1st 24 hrs. Nat.....

1st 24 hrs. after shot.....

Gas.....Cu. Ft.

Dry Hole.....

Abandoned.....

Date

MAY 14 1930

S. J. LEWIS Scout

Map No. KANSAS Sec. 4 Twp. 21 R. 3W

Well No. 6 Store house

Sinclair Oil Co. Company

Contractor

**SECTION PLAT**

			0

330 Ft. from N. Line

\_\_\_\_\_ Ft. from S. Line

330 Ft. from E. Line

\_\_\_\_\_ Ft. from W. Line

**COMPLETED**

Location \_\_\_\_\_

Rig up \_\_\_\_\_

Drilling and Remarks:

*Wilcox 3330-64*

*swa to 900 ft*

**RECORD**

Cased \_\_\_\_\_ in., \_\_\_\_\_ ft.

Sand \_\_\_\_\_

Gas \_\_\_\_\_

Oil \_\_\_\_\_

Total Depth 3364

**PRODUCTION**

1st 24 hrs. Nat. \_\_\_\_\_

1st 24 hrs. after shot \_\_\_\_\_

Gas \_\_\_\_\_ Cu. Ft.

Dry Hole \_\_\_\_\_

Abandoned \_\_\_\_\_

Date

JUN 25 1930

S. J. LEWIS Scout