


McPherson
Form 51-5M-1-30-38840

Map No. KANSAS Sec. 9 Twp. 21 R. 3w

Well No. 1 - Stucky Farm
United Oil & Shell Company

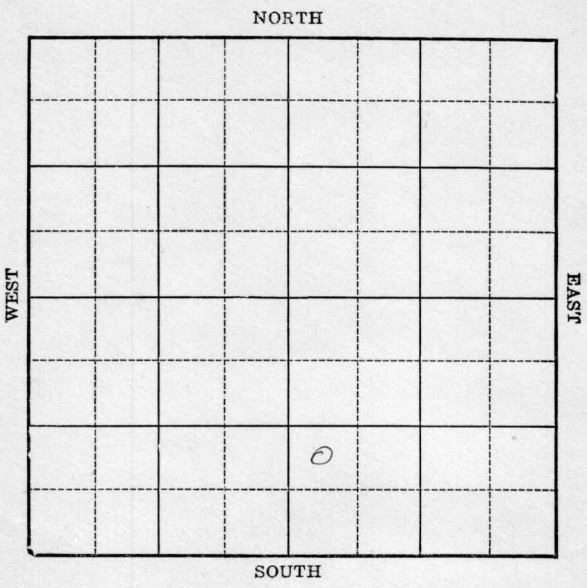

Location _____
Drilling Remarks _____

Rig Up _____
Drilling Remarks _____

RECORD


Cased _____ in. _____ ft.
Sand _____
Gas _____
Oil _____
Total Depth _____

PRODUCTION

1st 24 hrs. Nat. _____
1st 24 hrs. after shot _____
Gas _____ cu. ft. _____
Dry Hole _____
Abandoned _____

Map No. KANSAS Sec. 9 Twp. 21 R. 3^w
Well No. 1- Stuckey Farm
United Oil & Shell Company

_____ Ft. from N. Line
990 Ft. from S. Line
_____ Ft. from E. Line
330 Ft. from W. Line
1930

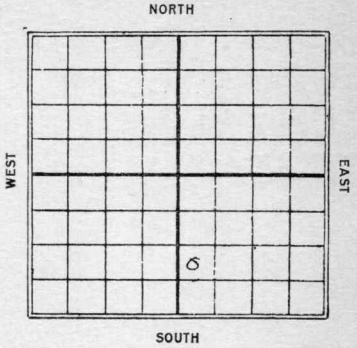

Date	REPORT
9/10	Reg
9/17	
9/24	
10/11	Riser up
10/18	Drill - 20" - 103
10/15	Drill 400'
10/22	" 890
10/29	12 1/2" - 1370'
11/5	Drill 1703'
11/12	" 1825'
11/19	" 2115
11/25	" 2310' N7W
	2150 - 76'
12/2	Drill 2535
12/10	" 2560
12/17	" 2720
12/23	" 2840'
12/30	Top Chat 2995
	Show gas 3000
	Drill 3030' Chat
	(over)

1931

1/7- SD 3030

1/14- Base Miss 3080
Drly 3226

1/21- Top Viola 3335
Show oil 3348-52
Base Viola 3358
Wilcox 3369

Oil 3373-75
Sandy shale 3375-80
1500' oil in hole

1/28- T.D. 3410 SD.

swab 260 bbl oil

2/4- Wilcox 3369-3418
T.D. 3418

Pump 260 bbl oil
Comp.

M. Horton

(21)

Map No. **KANSAS** Sec. 9 Twp. 20 R. 3W
43 9 21 3W

Well No. 1 Stuckey

United Petroleum Company

Contractor

SECTION PLAT

..... Ft. from N. Line

990 Ft. from S. Line

..... Ft. from E. Line

930 Ft. from W. Line

FIRST REPORTS

Location.....

Rig up.....

Drilling and Remarks:

*Rig
10 acres*

RECORD

Cased..... in., ft.

Sand.....

Gas.....

Oil.....

Total Depth.....

PRODUCTION

1st 24 hrs. Nat.

1st 24 hrs. after shot.....

Gas..... Cu. Ft.

Dry Hole.....

Abandoned.....

Date

SEP 10 1930

192.....

S. J. LEWIS

Scout

M. Person

Map No. KANSAS Sec. 9 Twp. 21 R. 3W

Well No. 43 Stucky

United Oil & Well Company

Contractor

SECTION PLAT

..... Ft. from N. Line

990 Ft. from S. Line

..... Ft. from E. Line

330 Ft. from W. Line

		o	

COMPLETED

Location.....

Rig up..... *Wilson*

Drilling and Remarks:

*260 x 8 1/2.
Pumps*

RECORD

Cased..... in., ft.

Sand 9369-3418.

Gas.....

Oil.....

Total Depth 3418

PRODUCTION

1st 24 hrs. Nat.....

1st 24 hrs. after shot.....

Gas..... Cu. Ft.

Dry Hole.....

Abandoned.....

Date

FEB 4 1931

S. J. LEWIS Scout