
FORM 61 NO-RECORD

McPherson Co. KANSAS
O.W.W.O.

Section 9 Township 21 Range 3W

Well No. 1 Stucky (Stuckey)

Company Derby Oil

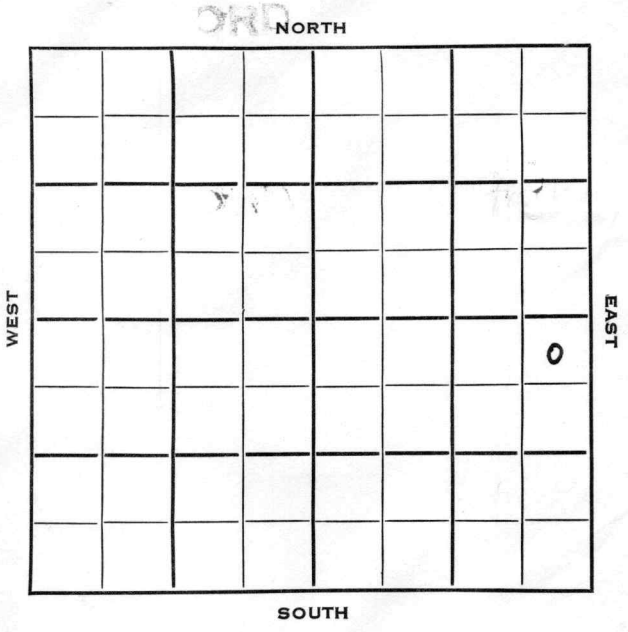

McPherson

FORM 252A-5M-12-28-PETROL

O. W. D. D

Map No. KANSAS Sec. 9 Twp. 21 R. 3W

Well No. 1 Stuckey Farm

Derby Oil Company


330 Ft. from N. Line

Ft. from S. Line

330 Ft. from E. Line

Ft. from W. Line

1929 NE NE SE

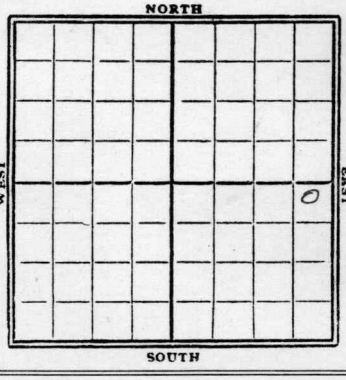

Date	Elev. 1446' REPORT
7/17	Rotary
7/24	Cellar
7/31	Bldg Rig
8/7	198' surface pipe
8/14	Drlg 1500'
8-21	" 2281'
8/28	" 3620'
9/4	" 2975
9/11	C.O. 2985
9/18	T.D. 2985 - Rust
9/25	Top lime 3005
	Base lime 3025
	Drlg 3039 in shale
10/4	Top Wilcox 3322
	T.D 3325 filled 1500
	Oil - 50 minutes
	6" set 3281 - 8" - 3003
	flowed 115 bbls
	2 hrs from between
	6" & 8" csgs
10/8	swab & flow 1000 bbls 18 hrs
	T.D. 3325'

OVER

10/9- Top Sand 3318'
T.D. 3325'
swab 1052 bbl oil
41° gravity
Comp.

1930
4/9- OWDD
Silo lime 3380-92
T.D. 3392
1460 bbl oil
Comp

1954
4/7 O.W.D.D
Spud 2-28-54
SWDW Well
TD 3885'
OTD 3325'
DD 3885'
Ran 490' of 5" liner @ 3325
CO to 3885'
Input 30 bwph 5000A
Comp. 240 bwph

FIRST REPORT

ABANDONED

Form 26—1M Bks.—2-29

Map No. KANSAS Sec. 9 Twp. 21 R. 3 W


43

Well No. 1 Stucky

Derby Oil Company

Contractor

SECTION PLAT

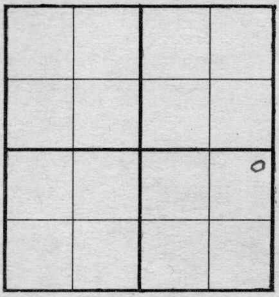

330 Ft. from N. Line

____ Ft. from S. Line

330 Ft. from E. Line

____ Ft. from W. Line

FIRST REPORTS

Location ✓

Rig up

Drilling and Remarks:

Rotary

RECORD

Cased ____ in., ____ ft.

Sand

Gas

Oil

Total Depth

PRODUCTION

1st 24 hrs. Nat.

1st 24 hrs. after shot

Gas ____ Cu. Ft.

Dry Hole

Abandoned

Date

JUL 17 1929 19 S. J. LEWIS Scout

Form 26—1M Blks.—9-28

M Nelson

Map No. KANSAS Sec. 9 Twp. 21 R. 8W


43

Well No. 1 Stucky

Derby Oil Co. Company

Contractor

SECTION PLAT

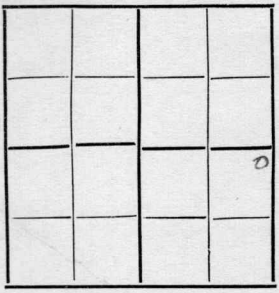

3330 Ft. from N. Line

Ft. from S. Line

330 Ft. from E. Line

Ft. from W. Line

COMPLETED

Location

Rig up

Drilling and Remarks:

Top Sand 3318.

Swabbed 1052 BBLS

41° gravity

RECORD

Cased in., ft.

Sand

Gas

Oil

Total Depth 3325

PRODUCTION

1st 24 hrs. Nat.

1st 24 hrs. after shot

Gas Cu. Ft.

Dry Hole

Abandoned

Date

OCT 9 1929

192

S. J. LEWIS Scout

Form 26—1M Bks.—9-28

McPherson

Map No. KANSAS Sec. 9 Twp. 21 R. 3 W


43

Well No. 1 Stuckey

Derby Oil Co. Company

Contractor

SECTION PLAT

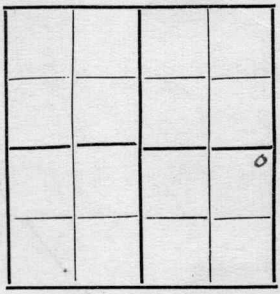

330 Ft. from N. Line

Ft. from S. Line

330 Ft. from E. Line

Ft. from W. Line

FIRST REPORTS

COMPLETED

OWWO

Location

Rig up

Drilling and Remarks:

Siliceous lime

3380 - 3392

1460 BBLS.

RECORD

Cased in., ft.

Sand

Gas

Oil

Total Depth 3392

PRODUCTION

1st 24 hrs. Nat.

1st 24 hrs. after shot

Gas Cu. Ft.

Dry Hole

Abandoned

Date

APR 9 1930

192

S. J. LEWIS Scout

FORM 275 FOR SALE BY KANSAS BLUE PRINT CO.

Q.W.W.O.

County McPherson State Kansas

Sec. 9 (Blk. Twp.) 21 (Sur. Rge.) 3W Map No.

Operator Derby Oil

Well No. 1 Farm Stucky

NO-RECORD

Elev. 1446 Location NW NE SE



330 Ft. From N Line SE

330 Ft. From E Line Quarter

1st. Report APR 7 1954

Completion APR 7 1954

Remarks SWDW

Spudding Date 2-28-54

Drlg. Data SWDW well TD 3885 Voshell Pool

OTD 3325 DD 3885 ran 490' of 5" liner

@ 3325 CO to 3885 Input 30 bwph 5000 A

Comp. 240 bwph

J. G. McGEHEE