


Map No. KANSAS Sec. 9 Twp. 21 R. 3^w
Well No. 3- Stucky Farm
Derby Oil Company

NORTH

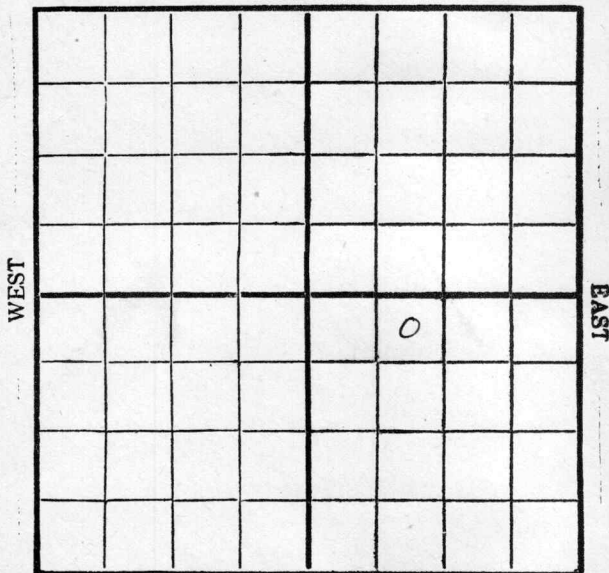

SOUTH

Location _____

Drilling Remarks

RECORD

Cased _____ in. _____ ft.

Sand _____

Gas _____

Oil _____

Total Depth _____

Rig Up _____

Drilling Remarks

PRODUCTION

1st 24 hrs. Nat. _____

1st 24 hrs. after shot _____

Gas _____ cu. ft. _____

Dry Hole _____

Abandoned _____

Map No. KANSAS Sec. 9 Twp. 21 R. 3^w
 Well No. 3- Stucky Farm
Derby Oil Company


330 Ft. from N. Line

_____ Ft. from S. Line

_____ Ft. from E. Line

990 Ft. from W. Line

1930

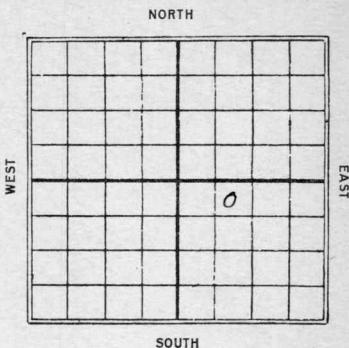

Date

REPORT

1/8	Bldg Rig
1/15	
1/22	Rig up
1/29	Wdlg 168'
2/5	" 1447'
2/12	" 2080'
2/19	" 2547'
2/26	" 2672'
3/5	Trg. tools 2672'
3/12	
3/19	Trg. tools 2840'
3/26	Wdlg. 2943'
4/2	" 3017 Top Chat
	2967'
4/9	Top Viola 3267'
	Wdlg 3307'
4/16	Wilcox 3329'
	Circ line 3382-89
	TD 3389'
	swab 1504 bbl oil
	Comp.

Map No. KANSAS Sec. 9 Twp. 21 R. 3 W

Well No. 3 Stuckey

Terry Oil Company

Contractor

SECTION PLAT

		o	

320 Ft. from N. Line

_____ Ft. from S. Line

_____ Ft. from E. Line

990 Ft. from W. Line

FIRST REPORTS

Location _____

Rig up _____

Drilling and Remarks:

Building rig
R. Stuckey

RECORD

Cased _____ in., _____ ft.

Sand _____

Gas _____

Oil _____

Total Depth _____

PRODUCTION

1st 24 hrs. Nat. _____

1st 24 hrs. after shot _____

Gas _____ Cu. Ft.

Dry Hole _____

Abandoned _____

Date

JAN 8 1930

19

S. J. LEWIS

Scout

Map No. KANSAS Sec. 9 Twp. 21 R. 3 WWell No. 3 Stucky

Company

Contractor

SECTION PLAT

		6	

830 Ft. from N. Line

..... Ft. from S. Line

..... Ft. from E. Line

990 Ft. from W. Line

COMPLETED

Location.....

Rig up.....

Drilling and Remarks:

Wilcox 3329Oil Lums 3382-89210a 88/15048810

RECORD

Cased.....in.,ft.

Sand.....

Gas.....

Oil.....

Total Depth 8389

PRODUCTION

1st 24 hrs. Nat.....

1st 24 hrs. after shot.....

Gas.....Cu. Ft.

Dry Hole.....

Abandoned.....

Date

APR 16 1930

192.....

S. J. LEWIS

Scout