


Map No. KANSAS Sec. 9 Twp. 21 R. 3^W
Well No. 7 Stucky Farm
Derby Oil Company

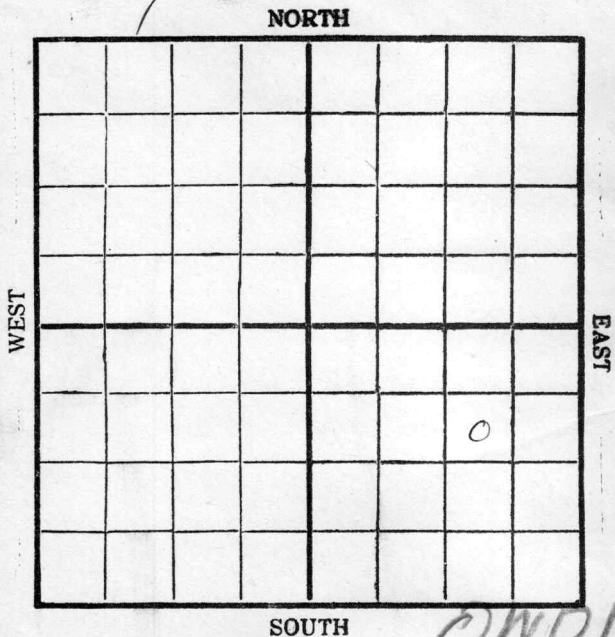

Location _____
Drilling Remarks _____

RECORD

Cased _____ in. _____ ft.
Sand _____
Gas _____
Oil _____
Total Depth _____

Rig Up _____
Drilling Remarks _____

PRODUCTION

1st 24 hrs. Nat. _____
1st 24 hrs. after shot _____
Gas _____ cu. ft. _____
Dry Hole _____
Abandoned _____

Map No. KANSAS Sec. 9 Twp. 21 R. 3^w
 Well No. 7- Stuckey Farm
Derby Oil Company

NORTH

WEST

EAST

SOUTH

990 Ft. from N. Line

_____ Ft. from S. Line

990 Ft. from E. Line

_____ Ft. from W. Line

1930

Date

REPORT

1/29	Root
2/5	Bldg. rig
2/12	Run up
2/19	15 $\frac{1}{2}$ @ 1800
2/26	Dulq. 1760.
3/5	" 2719'
3/12	Top Chat 9974 - Base line 3004' - Top Viola 3256 - T.D. 3275' - cement 8"
3/19	Wilcox 3331 - 3347 - swabbed 57 $\frac{1}{2}$ fbls 1 $\frac{1}{2}$ fbls.
3/26	Wilcox 3331 - 85' T.D. 3385' swab 552 bbl oil Comp.
1930	OWDD
4/2	Siliceous line 3395 - 3409 T.D. 3409 swab 1524 bbl oil Comp.

Map No. KANSAS Sec. 9 Twp. 21 R. 8 W

Well No. 7 Stuckey

Company

Contractor

SECTION PLAT

			0

990 Ft. from N. Line

..... Ft. from S. Line

990 Ft. from E. Line

..... Ft. from W. Line

FIRST REPORTS

Location.....

Rig up.....

Drilling and Remarks:

R.O.G.
Rotary

RECORD

Cased..... in., ft.

Sand.....

Gas.....

Oil.....

Total Depth.....

PRODUCTION

1st 24 hrs. Nat.....

1st 24 hrs. after shot.....

Gas..... Cu. Ft.

Dry Hole.....

Abandoned.....

Date

JAN 29 1930

192

S. J. LEWIS

Scout

Map No. KANSAS Sec. 9 Twp. 21 R. 3W

Well No. 2 Stuckey

Terby Oil Company

Contractor

SECTION PLAT

990 Ft. from N. Line

..... Ft. from S. Line

990 Ft. from E. Line

..... Ft. from W. Line

COMPLETED

Location.....

Rig up.....

Drilling and Remarks:

Wilcox 3331-85

swath
552 x 4 1/2

RECORD

Cased..... in., ft.

Sand.....

Gas.....

Oil.....

Total Depth 3385

PRODUCTION

1st 24 hrs. Nat.....

1st 24 hrs. after shot.....

Gas..... Cu. Ft.

Dry Hole.....

Abandoned.....

Date

MAR 26 1930

192

S. J. LEWIS

Scout

Map No. KANSAS Sec. 9 Twp. 21 R. 2W

Well No. 7 Stuckey

Company

Contractor

SECTION PLAT

			0

990 Ft. from N. Line

..... Ft. from S. Line

990 Ft. from E. Line

..... Ft. from W. Line

FIRST REPORTS
and
COMPLETED

OW 117

Location.....

Rig up.....

Drilling and Remarks:

Silicious lime

3395-3409

swath 1524 ft.

RECORD

Cased.....in.,ft.

Sand.....

Gas.....

Oil.....

Total Depth 3409

PRODUCTION

1st 24 hrs. Nat.....

1st 24 hrs. after shot.....

Gas.....Cu. Ft.

Dry Hole.....

Abandoned.....

Date

APR 2 - 1930.192

S. J. LEWIS

Scout