


Map No. KANSAS Sec. 9 Twp. 21 R. 3rd
Well No. 1 - Voskell Farm
Arrive & Amrada Company

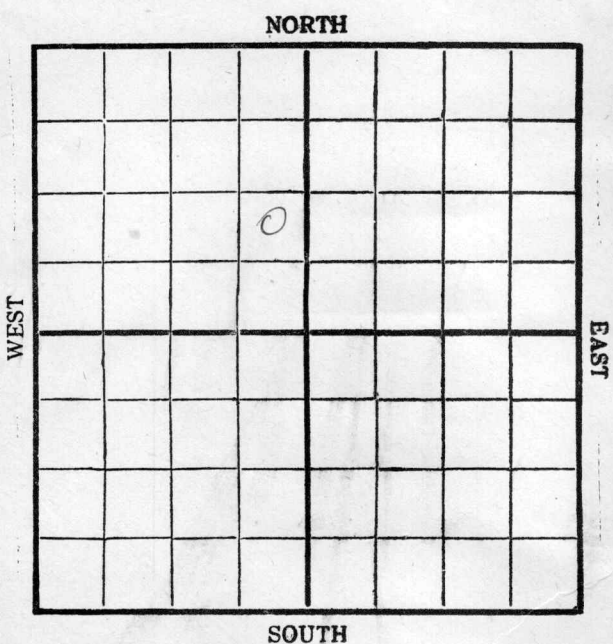

Location _____
Drilling Remarks _____

Rig Up _____
Drilling Remarks _____

RECORD

Cased _____ in. _____ ft.
Sand _____
Gas _____
Oil _____
Total Depth _____


PRODUCTION

1st 24 hrs. Nat. _____
1st 24 hrs. after shot _____
Gas _____ cu. ft. _____
Dry Hole _____
Abandoned _____

M. O. Pherson

Map No. KANSAS Sec. 9 Twp. 21 R. 3^w
 Well No. 1- Voshell Farm
Debie & Amurada Company

NORTH

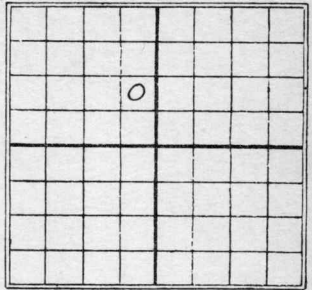

Ft. from N. Line

990 Ft. from S. Line

330 Ft. from E. Line

Ft. from W. Line

1930

SOUTH

Date

REPORT

Date	REPORT
1/8	Rod (rotary)
1/15	Bldg Rig
1/22	Rig up
1/29	
2/5	Dry 847
2/12	" 2340'
2/19	3095 - No Chat.
2/26	Test - 3381
3/6	Base Viola 3495 drilled into green shale dry 3515' brkn sand
3/8	Top Wilcox 3502 Had 1000' oil from lime Increase oil 3550-54 Now 1500' oil
3/10	T.D. 3554 Had 1500' oil swabbed dry Filled up 300' fluid mostly sulphur water
3/12	Dry 3571 (over)

3/19 - P.B. to 3409 - shot 60 gts.

3392 - 3405 Slg. out.

3/26 - T.D. 3571

Dry & Abandon

Map No. 43 **KANSAS** Sec. 9 Twp. 21 R. 2W

Well No. 1 Voshell

Hixie & Comrada Company

Contractor

SECTION PLAT

		o	

_____ Ft. from N. Line

990 Ft. from S. Line

380 Ft. from E. Line

_____ Ft. from W. Line

FIRST REPORTS

Location _____

Rig up _____

Drilling and Remarks:

*ROG
Rotary*

RECORD

Cased _____ in., _____ ft.

Sand _____

Gas _____

Oil _____

Total Depth _____

PRODUCTION

1st 24 hrs. Nat. _____

1st 24 hrs. after shot _____

Gas _____ Cu. Ft.

Dry Hole _____

Abandoned _____

Date

JAN 8 1930

S. J. LEWIS

Scout

Map No. KANSAS Sec. 9 Twp. 21 R. 3W

Well No. 43 1 Koskell

Hixie & Amerada Company

Contractor

SECTION PLAT

..... Ft. from N. Line

990 Ft. from S. Line

330 Ft. from E. Line

..... Ft. from W. Line

	0		

ABANDONED

Location.....

Rig up.....

Drilling and Remarks:

RECORD

Cased..... in., ft.

Sand.....

Gas.....

Oil.....

Total Depth 3571

PRODUCTION

1st 24 hrs. Nat.....

1st 24 hrs. after shot.....

Gas..... Cu. Ft.

Dry Hole.....

Abandoned.....

Date

MAR 26 1930

..... 192.....

S. J. LEWIS

Scout