


Map No. KANSAS Sec. 9 Twp. 21 R. 3^w
Well No. 2-Voshell Farm _____
Empire O & R Company _____

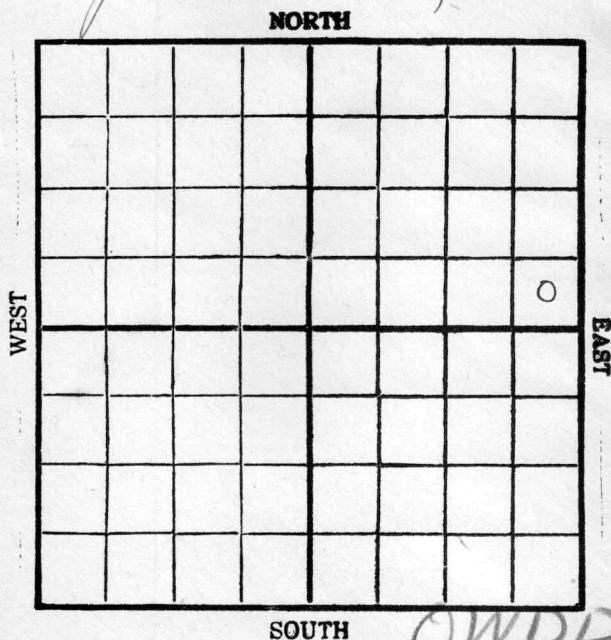

Location _____

Drilling Remarks _____

RECORD

Cased _____ in. _____ ft.

Sand _____

Gas _____

Oil _____

Total Depth _____

Rig Up _____

Drilling Remarks _____

PRODUCTION

1st 24 hrs. Nat. _____

1st 24 hrs. after shot _____

Gas _____ cu. ft. _____

Dry Hole _____

Abandoned _____


Map No. KANSAS Sec. 9 Twp. 21 R. 3^w
 Well No. 2 - Vashell Farm
Empire O & R Company

Ft. from N. Line

330 Ft. from S. Line

330 Ft. from E. Line

Ft. from W. Line

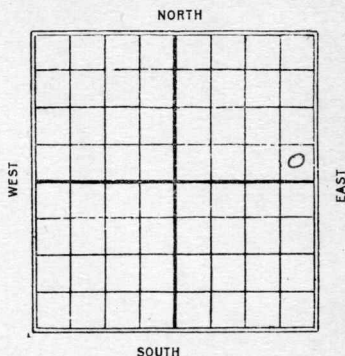

1929

Date

REPORT

10/9 Location

10/16 —

10/23 —

10/30 —

11/6 —

11/13 —

11/20 Bldg Rig

11/27 Rign up

12/4 Spud 210'

12/11 dily 950

12/18 " 1655'

12/23 " 1785'

12/30 " 2245'

1930

1/8 UIR 10"-2440'

1/15 dily 2610'

1/22 " 2805'

1/29 Top Chat 2980

Perm 8"-2982' T.D.

2/5 Top Viola Line 3281

run 6" (over)

2/11- Top Wilcox 3318'½'
Drly 3335' Swab
1254 bbls 24 hrs.
Drilled to 3336'
swab 815 bbl 10 hrs.

2/12- Wilcox 3318'½-36'
T.D. 3336'
swab 1822 bbls oil

Pump:

1930

OWDD

4/9- Silc line 3397-3400

T.D. 3400

472 bbl oil 5 hr

Pump.

Map No. KANSAS Sec. 9 Twp. 21 R. 2W

Well No. 43 2 Voshell

Empire Oil & Ref. Company

Contractor

SECTION PLAT

..... Ft. from N. Line

330 Ft. from S. Line

330 Ft. from E. Line

..... Ft. from W. Line

			!
			0

FIRST REPORTS

Location ✓

Rig up

Drilling and Remarks:

RECORD

Cased..... in., ft.

Sand

Gas

Oil

Total Depth

PRODUCTION

1st 24 hrs. Nat.

1st 24 hrs. after shot

Gas..... Cu. Ft.

Dry Hole

Abandoned

Date

OCT 9 1929

S. J. LEWIS Scout

Map No. KANSAS Sec. 9 Twp. 21 R. 3W

Well No. 2 Voshell

Empire Oil & Ref. Company

Contractor

SECTION PLAT

			0

.....Ft. from N. Line

330 Ft. from S. Line

330 Ft. from E. Line

.....Ft. from W. Line

COMPLETED

Location.....

Rig up.....

Drilling and Remarks:

Wilcox 3318 1/2 ft
3336

Swarted 1822 ft

RECORD

Cased.....in.,ft.

Sand.....

Gas.....

Oil.....

Total Depth 3336

PRODUCTION

1st 24 hrs. Nat.....

1st 24 hrs. after shot.....

Gas.....Cu. Ft.

Dry Hole.....

Abandoned.....

Date

FEB 12 1930

192

S. J. LEWIS

Scout

Map No. KANSAS Sec. 9 Twp. 21 R. 8W

Well No. 2 Voshell

Empire Oil & Ref. Company

Contractor

SECTION PLAT

			0

Ft. from N. Line

330 Ft. from S. Line

330 Ft. from E. Line

Ft. from W. Line

FIRST REPORTS

COMPLETED

OWNED

Location [REDACTED]

Rig up [REDACTED]

Drilling and Remarks:

Sil line 3397-3400

472 fms.

5 hrs.

RECORD

Cased in., ft.

Sand

Gas

Oil

Total Depth 2400

PRODUCTION

1st 24 hrs. Nat.

1st 24 hrs. after shot

Gas Cu. Ft.

Dry Hole

Abandoned

Date

APR 9 - 1930

S. J. LEWIS Scout