


McPherson

Section 9 Township 21 Range 3WWell No. #2 VoshellCompany Pam Kar

NORTH

WEST

EAST

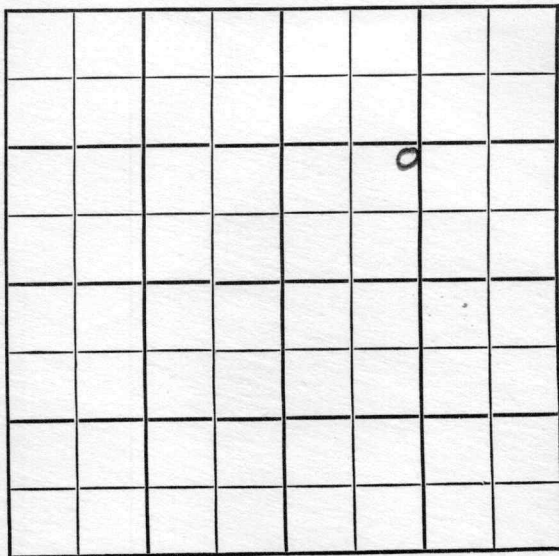

SOUTH

McPherson

KANSAS

SEC.	TWP.	R.
9	21	3 W

WELL NO.

2 Voshell

FARM

COMPANY

Pam Kar

CONTRACTOR

Brinrich


_____ Ft. from N. Line

_____ Ft. from S. Line

_____ Ft. from E. Line

_____ Ft. from W. Line

NE SW NE

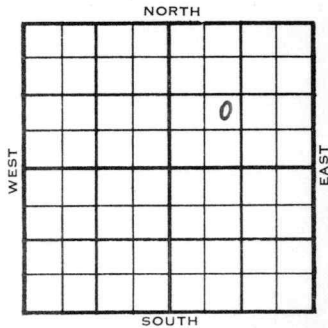

1955

ELEVATION

REPORT

6/8

MIR

7/7

Comm 6-8-55

8 5/8" @ 257/200, 5 1/2" @ 3435 8/3332-34

S 4 1/2 boph 2 hr. P/25 bopd Comp. 25
bodd.

Tops:	Depth	Datum
BL.	2305	860
L.	2347	902
M.	2945	1500
K.	2978	1533
Mz.	3221	1776
V.	3222	1777
S.	3263	1818
A.	3333	1888
TD.	3435	

COMPLETED

County McPherson Elev. _____ Co. _____
 Sec. 9 Twp. 21 Rge. 3W
 Company Pam Kar
 Farm Name Voshell No. 2

TOPS	DEPTH	LOG	DATUM	Loc. in Sec.
Anh.				NE SW NE
Tp.				
H.				
Tr.				
Dg.				
BL.				
L.				Geol. _____
K.C.				Contr. _____
B.K.C.				<u>Brinrich</u>
Ce.				Pool _____
C.				
M.				
M.				
K.				
Mz.				
Me.				
V.				
S.				
S.				
A.				
R.				
Pe.				
G.				
T.D.				

REPORT
JUN 8 '35

Date Comm.

M I R

County McPherson Elev. 1445
Sec. 9 Twp. 21 Rge. 3W
Company Pam-Kay
Farm Name Voshell No. 2

TOPS	DEPTH	LOG	DATUM
Anh.			
Tp.			
H.			
Tr.			
Dg.			
BL.	2305		860
L.	2347		902
K.C.			
B.K.C.			
Ce.			
C.			
M.	2945		1500
M.			
K.	2978		1533
Mz.	3221		1776
Mq.			
V.	3222		1777
S.	3263		1818
S.			
A.	3333		1888
R.			
Pe.			
G.	5 1/2		
T.D.	3435		1990

Loc. in Sec. NE SW NE
Geol. _____

Contr. Brinrich

Pool _____

9

COMPLETE

Date Comm. 6-8-55 JUL 6 1955
8 5/8" @ 257/200 5 1/2" @ 3435 8/ 3332-34
S/ 4 1/2 boph 2 hr. P/ 25 bopd
Comp. 25 bopd