


Map No. KANSAS Sec. 9 Twp. 21 R. 3^w
Well No. 3- Toshell Farm
H. C. M^c Bride, Inc. Company

330 Ft. from N. Line
_____ Ft. from S. Line
990 Ft. from E. Line
_____ Ft. from W. Line

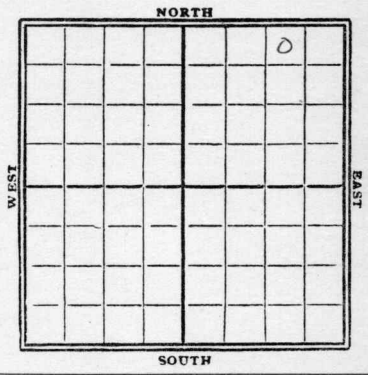

1929

Date	REPORT
12/11	Location
12/18	Bldy Rig
12/23	Rig up
12/30	Spud
1930	
1/8	Cut 15" - 890'
1/15	Dry 1460'
1/22	Log tools 1705'
1/29	
2/5	Dry 1729'
2/12	2100 Log under-
2/19	reamer.
2/26	2312 W/R 12"
3/5	Dry 2450'
3/12	" 2716
3/19	" 3162 Top Shot
	2939'
3/26	Top Viola 3238-64
	Swabbed 240 bbls
	5 hrs. - (over)

Wilcox 3284-95-
No test.

4/2- Top Sil. lime 3337
Wily 3345- Swabbed
1000 bbls 14 hrs.

~~1930 01120~~

4/9- Silc lime 3337-45
T.D. 3345
swab 1290 bbl
Comp.

Map No. KANSAS Sec. 9 Twp. 21 R. 2W

Well No. 3 Voshell

H. C. McBride Inc. Company

Contractor

SECTION PLAT

			6

300 Ft. from N. Line

..... Ft. from S. Line

990 Ft. from E. Line

..... Ft. from W. Line

FIRST REPORTS

Location ✓

Rig up

Drilling and Remarks:

RECORD

Cased..... in., ft.

Sand.....

Gas.....

Oil.....

Total Depth.....

PRODUCTION

1st 24 hrs. Nat.....

1st 24 hrs. after shot.....

Gas..... Cu. Ft.

Dry Hole.....

Abandoned.....

Date

DEC 1 1 1929

192

S. J. LEWIS

Scout

Map No. KANSAS Sec. 9 Twp. 21 R. 2W

Well No. 3 Voshell

H.C. McBride Inc. Company

Contractor

SECTION PLAT

330 Ft. from N. Line

..... Ft. from S. Line

990 Ft. from E. Line

..... Ft. from W. Line

			0

COMPLETED

Location.....

Rig up.....

Drilling and Remarks:

Vida line 3288-64

Wilcox 3284-95

sway 492876

Bible line 3337-45

sway 1290876

RECORD

Cased.....in.,ft.

Sand.....

Gas.....

Oil.....

Total Depth 2245

PRODUCTION

1st 24 hrs. Nat.....

1st 24 hrs. after shot.....

Gas.....Cu. Ft.

Dry Hole.....

Abandoned.....

Date

APR 9 - 1930
.....192.....

S. J. LEWIS Scout