


Map No. KANSAS Sec. 9 Twp. 21 R. 3<sup>w</sup>

Well No. 3- Voshell Farm \_\_\_\_\_  
Empire Oil Company \_\_\_\_\_

NORTH

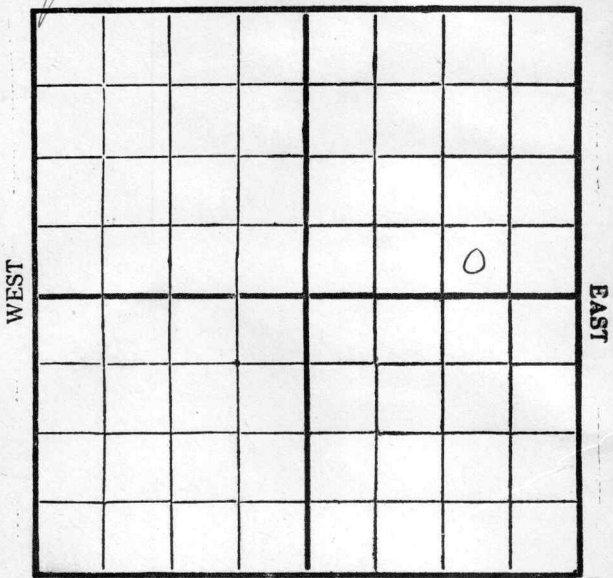

SOUTH

*OWDD*

Location \_\_\_\_\_  
Drilling Remarks \_\_\_\_\_

Rig Up \_\_\_\_\_  
Drilling Remarks \_\_\_\_\_

\_\_\_\_\_  
\_\_\_\_\_  
RECORD


PRODUCTION

Cased \_\_\_\_\_ in. \_\_\_\_\_ ft.  
Sand \_\_\_\_\_  
Gas \_\_\_\_\_  
Oil \_\_\_\_\_  
Total Depth \_\_\_\_\_

1st 24 hrs. Nat. \_\_\_\_\_  
1st 24 hrs. after shot \_\_\_\_\_  
Gas \_\_\_\_\_ cu. ft. \_\_\_\_\_  
Dry Hole \_\_\_\_\_  
Abandoned \_\_\_\_\_

Map No. KANSAS Sec. 9 Twp. 21 R. 3w  
Well No. 3-Voshell Farm  
Empire O & R Company

\_\_\_\_\_ Ft. from N. Line  
330 Ft. from S. Line  
990 Ft. from E. Line  
\_\_\_\_\_ Ft. from W. Line

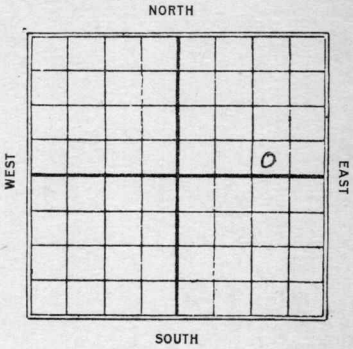

1929

Date	REPORT
<u>12/30</u>	<u>Rot. (rotary)</u>
<u>1930</u>	
<u>1/18</u>	<u>Bldg Rig</u>
<u>1/15</u>	
<u>1/22</u>	<u>Run up</u>
<u>1/29</u>	<u>set 15 1/2" 158'</u>
<u>2/5</u>	<u>Orlg. 930</u>
<u>2/12</u>	<u>" 1255'</u>
<u>2/19</u>	<u>" 1900</u>
<u>2/26</u>	<u>" 2420.</u>
<u>3/5</u>	<u>" 2888.</u>
<u>3/12</u>	<u>Top Chat 2985-</u> <u>T.D. 3010 Rust.</u>
<u>3/19</u>	<u>Top Viola 3290-</u> <u>Orlg. 3327</u>
<u>3/26</u>	<u>Milcox 3327-64'</u> <u>T.D. 3364</u> <u>swab 220 bbl oil</u> <u>Comp.</u>
<u>1930</u>	<u>OWDD</u>
<u>4/2</u>	<u>Selec lime 3389-94 T.D.</u> <u>swab 1295 bbl oil</u> <u>Comp.</u>

43

Map No. KANSAS Sec. 9 Twp. 21 R. 3W

Well No. 3 Voshell

Empire Oil & Ref. Company  
Contractor

**SECTION PLAT**

			0

\_\_\_\_\_ Ft. from N. Line

330 Ft. from S. Line

990 Ft. from E. Line

\_\_\_\_\_ Ft. from W. Line

FIRST REPORTS

Location \_\_\_\_\_

Rig up \_\_\_\_\_

Drilling and Remarks:

*Rotary*  
*R O G*

**RECORD**

Cased \_\_\_\_\_ in., \_\_\_\_\_ ft.

Sand \_\_\_\_\_

Gas \_\_\_\_\_

Oil \_\_\_\_\_

Total Depth \_\_\_\_\_

**PRODUCTION**

1st 24 hrs. Nat. \_\_\_\_\_

1st 24 hrs. after shot \_\_\_\_\_

Gas \_\_\_\_\_ Cu. Ft.

Dry Hole \_\_\_\_\_

Abandoned \_\_\_\_\_

Date

DEC 30 1929

19

S. J. LEWIS

Scout

Map No. **KANSAS** Sec. 9 Twp. 21 R. 8 W.

Well No. 3 Vashell

Empire Oil & Ref Company

Contractor

**SECTION PLAT**

..... Ft. from N. Line

320 Ft. from S. Line

990 Ft. from E. Line

..... Ft. from W. Line

			0

**COMPLETED**

Location.....

Rig up.....

Drilling and Remarks:

Wilcox 3327-3364

swab 220 ft.

**RECORD**

Cased..... in., ..... ft.

Sand.....

Gas.....

Oil.....

Total Depth 336.4

**PRODUCTION**

1st 24 hrs. Nat.....

1st 24 hrs. after shot.....

Gas..... Cu. Ft.

Dry Hole.....

Abandoned.....

Date

**MAR 26 1930**

192

**S. J. LEWIS**

Scout

Map No. KANSAS Sec. 9 Twp. 21 R. 2W

43

Well No. 3 Voskell

Empire Oil & Ref. Company

Contractor

SECTION PLAT

			0

..... Ft. from N. Line

330 Ft. from S. Line

990 Ft. from E. Line

..... Ft. from W. Line

FIRST REPORTS

COMPLETED

OW 111

Location.....

Rig up.....

Drilling and Remarks:

Site close time

3389-94

swatted 1295 ft

RECORD

Cased.....in., .....ft.

Sand.....

Gas.....

Oil.....

Total Depth 3294

PRODUCTION

1st 24 hrs. Nat.....

1st 24 hrs. after shot.....

Gas.....Cu. Ft.

Dry Hole.....

Abandoned.....

Date

APR 2 - 1930

S. J. LEWIS

Scout