


Section 9 Township 21 Range 3 W

Well No. #5 Voshell

Company Ray Law & Jack Spear

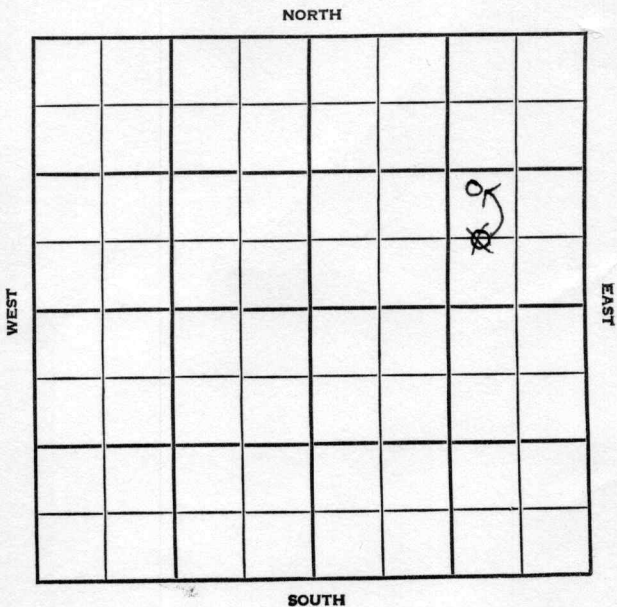

McPherson

KANSAS

SEC.	TWP.	R.
9	21	3W

WELL NO. #5 Voshell FARM

COMPANY Ray Law & Jack Spear

CONTRACTOR Mallard

Voshel


_____ Ft. from N. Line

990 _____ Ft. from S. Line

1150 _____ Ft. from E. Line

_____ Ft. from W. Line

~~0~~ ^{N.W} ₁ SE NE

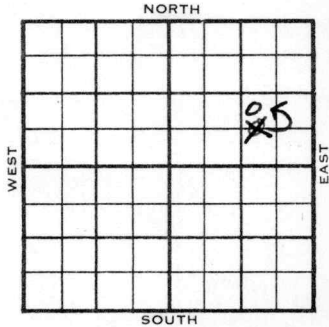

1955	ELEVATION 1446'	REPORT
------	-----------------	--------

8/17 Comm 8-12-55
10" @ 258
Drlg 1980

9-14 7" @ 3396
CO to 3390 16/ 3346-48
Comp. 40 bopd 390 bw
Tops: A 3345
T.D. 3396'

COMPLETED

County Mopherston Elev. _____
 Sec. 9 Twp. 21 Rge. 3W
 Company Ray Law & Jack Spear
 Farm Name Voshell No. 5

TOPS	DEPTH	LOG	DATUM
Anh.			
TP.			
H.			
Tr.			
Dg.			
BL.			
L.			
K.C.			
B.K.C.			
Ce.			
C.			
M.			
M.			
K.			
Mz.			
Me.			
V.			
S.			
S.			
A.			
R.			
PC.			
G.			
T.D.			

Loc. in Sec. C W 1/2 SE NE

Geol. _____

Contr. Mallard

Pool _____

Voshell

AUG 17 1955	0
FIRST REPORT	

Date Comm. 8-12-55

10" @ 258 drlg. 1980

Co.

Lse.

T.No.

Sec.

T.

R.

SCOUT TICKET

DX-201

Kansas

SEC.

TWP.

R.

9

27

3W

WELL NO.

COMPANY

5 Voshell

FARM

Ray Law & Jack Spear

CONTRACTOR

CORRECTION

NW SE NE

FT. FROM N. LINE


990

FT. FROM S. LINE

1150

FT. FORM E. LINE

FT. FROM W. LINE

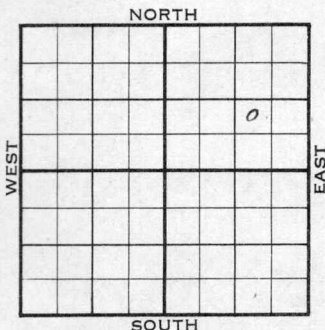

McPherson County

LOCATION

RIG UP

DRILLING AND REMARKS:

Reported

C W $\frac{1}{2}$ SE NE

RECORD

CASED IN., FT.

SAND

GAS

OIL

TOTAL DEPTH

PRODUCTION

1ST 24 HRS. NAT.

1ST 24 HRS. AFTER SHOT

GAS CU. FT.

DRY HOLE

ABANDONED

DATE

AUG 17 1955

SCOUT

County McPherson Elev. 1446
 Sec. 9 Twp. 21 Rge. 3W
 Company Ray Law & Jack Spear
 Farm Name Voshell No. 5

TOPS	DEPTH	LOG	DATUM	Loc. in Sec.
Anh.				NW SE NE
TP.				
H.				1150' EL.
Tr.				
Dg.				
Bl.				
L.				Geol.
K.C.				Contr.
B.K.C.				Mallard
Ce.				Pool
C.				Voshell
M.				
M.				
K.				
Mz.				
Me.				
V.				
S.				
S.				
A	3345		1899	
R.				
PE.				
G.				
T.D.	3396			



Date Comm. 8-12-55 SEP 14 1955

10" @ 258 7" @ 3396 CO to 3390

16/ 3316-18 Comp. 10 bopd 390 bw

Co.
Lse.
No.
Sec.
T.
R.