


Map No. KANSAS Sec. 10 Twp. 21 R. 3^w
Well No. 3 - Vos Kelly Farm _____
Dinclair O & G Company _____

NORTH

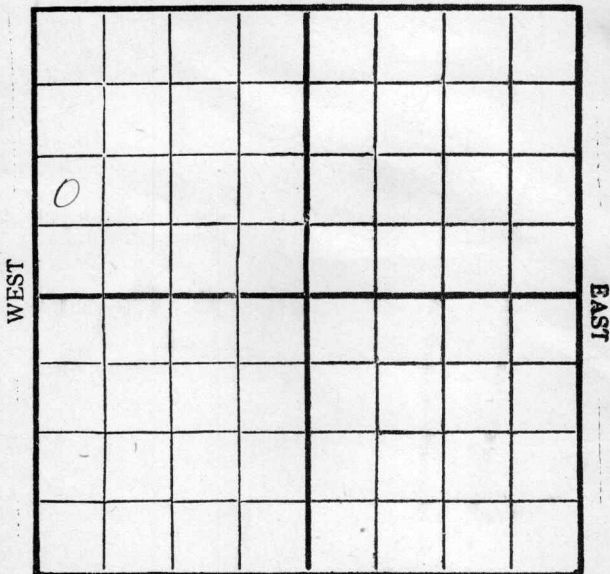

SOUTH

OWDD

Location _____

Drilling Remarks _____

Rig Up _____

Drilling Remarks _____

RECORD

Cased _____ in. _____ ft.

Sand _____

Gas _____

Oil _____

Total Depth _____

PRODUCTION

1st 24 hrs. Nat. _____

1st 24 hrs. after shot _____


Gas _____ cu. ft.

Dry Hole _____

Abandoned _____

Map No. KANSAS Sec. 10 Twp. 21 R. 3^W
 Well No. 3- Voskell Farm
Sinclair Oil Co Company

NORTH

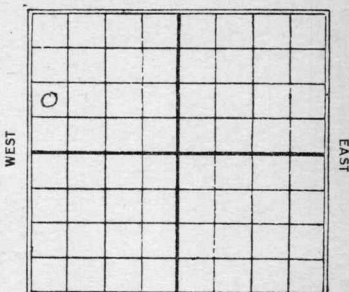

Ft. from N. Line

990 Ft. from S. Line

Ft. from E. Line

330 Ft. from W. Line

1929

Date

REPORT

12/23	Root
12/30	Bldg Rig
1930	Drly 510'
1/8	" 1550'
1/15	" 2360'
1/22	" 2880'
1/29	8" 3050 Rust.
2/5	Ply out 3060'
2/12	
2/19	
2/26	
3/5	Drly. 3062'
3/12	W/R 6" - 3319'
3/19	Top Viola 3320-
	Drly. 3324'
3/26	Mulcor 3354-66'
	T.D. 3360
	swab 490 bbl oil
	Comp.
1930	OWDD
4/19	Sile line 3423-27 T.D.
	swab 1738 bbl

Map No. KANSAS Sec. 10 Twp. 21 R. 2W

Well No. 43 3 Vossell

Sinclair O & G. Company

Contractor

SECTION PLAT

0			

Ft. from N. Line

990 Ft. from S. Line

Ft. from E. Line

830 Ft. from W. Line

FIRST REPORTS

Location

Rig up

Drilling and Remarks:

ROG

RECORD

Cased 1 in., ft.

Sand

Gas

Oil

Total Depth

PRODUCTION

1st 24 hrs. Nat.

1st 24 hrs. after shot

Gas Cu. Ft.

Dry Hole

Abandoned

Date

DEC 23 1929

192

S. J. LEWIS

Scout

Map No. 43 KANSAS Sec. 10 Twp. 21 R. 2W

Well No. 3 Voskell

Sinclair Oil Co. Company

Contractor

SECTION PLAT

0			

Ft. from N. Line

990 Ft. from S. Line

Ft. from E. Line

330 Ft. from W. Line

COMPLETED

Location

Rig up

Drilling and Remarks:

Wilcox 3354-66

swath 490 ft

RECORD

Cased in., ft.

Sand

Gas

Oil

Total Depth 336.6

PRODUCTION

1st 24 hrs. Nat.

1st 24 hrs. after shot

Gas Cu. Ft.

Dry Hole

Abandoned

Date

MAR 26 1930

192

S. J. LEWIS

Scout

Map No. KANSAS Sec. 10 Twp. 21 R. 2W
 Well No. 3 Rockwell

Sinclair Oil & Gas Company
 Contractor

SECTION PLAT

Ft. from N. Line

990 Ft. from S. Line

Ft. from E. Line

820 Ft. from W. Line

FIRST REPORTS
 COMPLETED

OWN

0			

Location

Rig up

Drilling and Remarks:

Oil line 8423-27

Swath 1738846

RECORD

Cased in., ft.

Sand

Gas

Oil

Total Depth 3427

PRODUCTION

1st 24 hrs. Nat.

1st 24 hrs. after shot

Gas Cu. Ft.

Dry Hole

Abandoned

Date

APR 9 1930

S. J. LEWIS Scout