


McPherson

Form 51-5M-2-29-34703

Map No. KANSAS Sec. 15 Twp. 21 R. 3w

Well No. 1- Newfeldt Farm
Ritz Oil and Shell Company

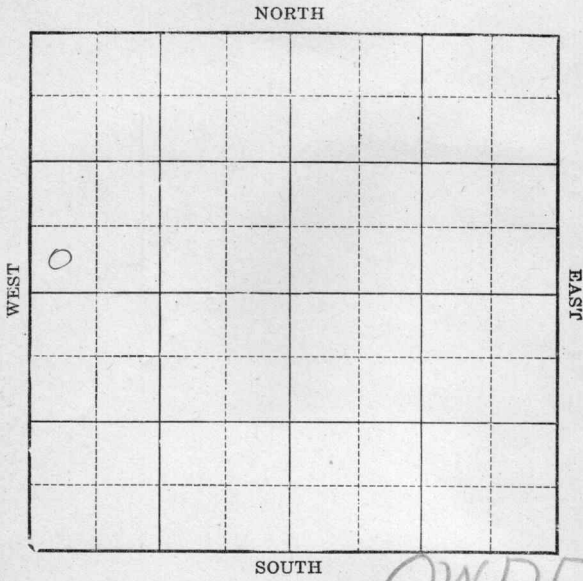

Location _____
Drilling Remarks _____

Rig Up _____
Drilling Remarks _____

RECORD

Cased _____ in. _____ ft.
Sand _____
Gas _____
Oil _____
Total Depth _____

PRODUCTION

1st 24 hrs. Nat. _____
1st 24 hrs. after shot _____
Gas _____ cu. ft. _____
Dry Hole _____
Abandoned _____

Map No. KANSAS Sec. 15 Twp. 21 R. 3^w

Well No. 1-Newfield Farm
Ritz Oil and Shell Company


 Ft. from N. Line

330 Ft. from S. Line

 Ft. from E. Line

330 Ft. from W. Line

1931

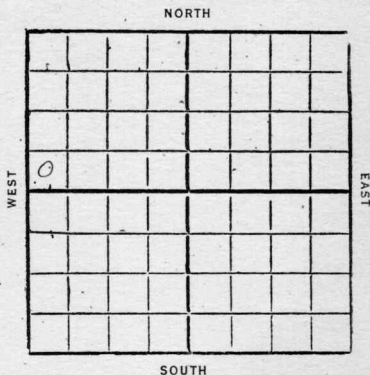

Date REPORT

5/27	Loc
6/3	BoS
6/10	BoS
6/17	BoS
6/24	Run up
7/1	215' sur pipe
7/8	S.D. 215'
7/15	
7/22	Drilg 2900'
7/29	Top Chat 3020
	T.D. 3023 Rng 8" csg
8/5	T.D. 3023' Rust
8/12	Drilg 3032
8/19	show oil 3045
	Pay 3080-85
	T.D. 3100'
	Swab 73 bbls 12 hrs
8/26	Chat 3020-3100
	T.D. 3100
	Pay 3080-85
	112 bbl oil
	(OWDD) (over) Comp.

1931

OWDD

12/16 - Old TD 3100

Prep to deepen

12/22 - Increase oil 3105-13

Drilg 3195'

12/30 - Base line 3398
show oil & gas 3408

Base Viola 3424

HFW 3440

Well PB to Chat

1932

1/6 - Top Melcor 3432

show oil 3437

HFW 3440

Well test show

1/13 - Base line 3142

Top Viola 3398

" Melcor 3432

show oil 3437

HFW 3440

Silic lime 3500-05

HFW 3503-05

Dry & Abandon

43 *McPherson*
 Map No. KANSAS Sec. 15 Twp. 21 R. 3 ^W

Well No. 1 *New field*
Ritz Oil Gas & Shell Company

Contractor

FIRST REPORTS

SECTION PLAT

/		/	
o		/	

Ft. from N. Line

330 Ft. from S. Line

Ft. from E. Line

330 Ft. from W. Line

Location ☒

Rig up

Drilling and Remarks:

RECORD

Cased _____ in., _____ ft.

Sand _____

Gas _____

Oil _____

Total Depth _____

PRODUCTION

1st 24 hrs. Nat. _____

1st 24 hrs. after shot _____

Gas _____ Cu. Ft.

Dry Hole _____

Abandoned _____

Date

MAY 27 1931

192

CHAS. L. SHERWOOD

Scout

Map No. KANSAS Sec. 15 Twp. 21 R. 3 W
 Well No. 43 1 Newfield
Ritz over gas & shell Company

Contractor

COMPLETED

SECTION PLAT

Ft. from N. Line

330 Ft. from S. Line

Ft. from E. Line

330 Ft. from W. Line

Location

Rig up

Drilling and Remarks:

Pay 3080-85112 Bls.

RECORD

Cased, _____ in., _____ ft.

Sand Chat 3020-3100

Gas _____

Oil _____

Total Depth 3100

PRODUCTION

1st 24 hrs. Nat. _____

1st 24 hrs. after shot _____

Gas _____ Cu. Ft.

Dry Hole _____

Abandoned _____

Date

AUG 26 1931

CHAS. L. SHERWOOD

192

Scout

43 KANSAS McPherson
 Map No. _____ Sec. 15 Twp. 21 R. 3^W

Well No. 1 New plat

Ritz Oil & Gas & Shell Company

Contractor

FIRST REPORTS

_____ Ft. from N. Line

330 _____ Ft. from S. Line

_____ Ft. from E. Line

330 _____ Ft. from W. Line

SECTION PLAT

0			

Location _____

Rig up Old TD 3100

Drilling and Remarks:

Prep to Deepen

RECORD

Cased _____ in., _____ ft.

Sand Chat 3070-3100

Gas _____

Oil _____

Total Depth _____

PRODUCTION

1st 24 hrs. Nat. _____

1st 24 hrs. after shot _____

Gas _____ Cu. Ft.

Dry Hole _____

Abandoned _____

Date

DEC 16 1931

192

CHAS. L. SHERWOOD

Scout

Map No. _____ Sec. 15 Twp. 21 R. 3 ^W

Well No. 1 Hempstead

Ritz Oil & Gas & Steel Company

Contractor

SECTION PLAT

COMPLETE

_____ Ft. from N. Line

330 Ft. from S. Line

_____ Ft. from E. Line

330 Ft. from W. Line

ABANDONED

0			

Location _____

RECORD

Cased _____ in., _____ ft.

Rig up _____

Sand _____

Drilling and Remarks:

Gas _____

Base line 3142

Oil _____

viola 3398

Total Depth 3505

Wilcox 3432 show Oil

3434 HFW 3440

Siliceous 3500-05

HFW 3503-05

D+a

PRODUCTION

1st 24 hrs. Nat. _____

1st 24 hrs. after shot _____

Gas _____ Cu. Ft.

Dry Hole ☒

Abandoned ☒

Date

JAN 13 1932

CHAS. L. SHERWOOD

192

Scout