


Section 19 Township 19 Range 9-W

Well No. #3 Robins

Company C. H. Weaver

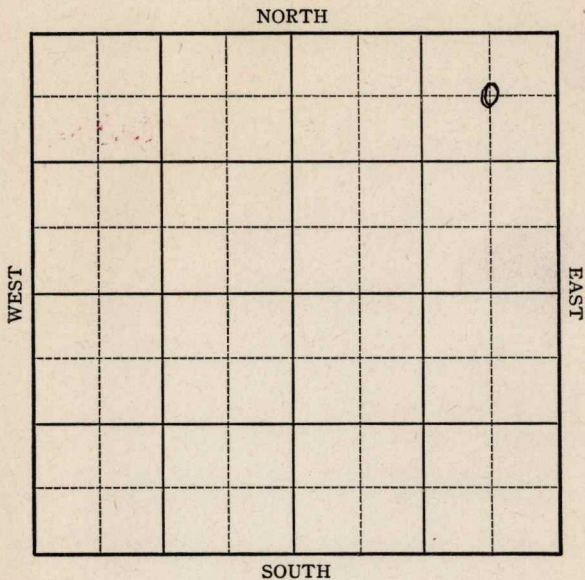

KANSAS

Rice

Sec. 19 Twp. 19 R. 9-W

Well No. #3 Robins Farm

C. H. Weaver Company

Chase Pool


660 Ft. from N. Line

 Ft. from S. Line

660 Ft. from E. Line

 Ft. from W. Line

El. 1728

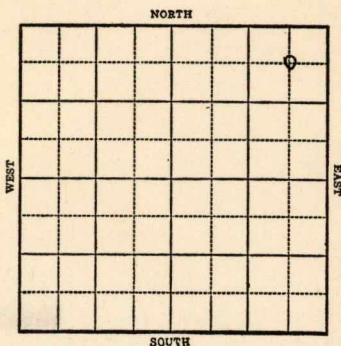

R E P O R T

1943

2/10 Rotary
2/17 8" Casing set 121
Anhy 438
Drlg. 1550
2/24 *Lans 2902*
Sat 2982-3004 3092-98
Drlg. 3120
3/3 *Arb 3256-57* TD
5" Casing set 3256 RUST.
3/10 TD 3266-3000' oil
3/17 *Arb. 3256*
5" @ 3256'
Pump 500 Pot.
T.D. 3266'
Gravity 44

COMPLETED

KANSASMap No. 49 Sec. 19 Twp. 19 R. 9WWell No. 3 RobinsC. H. Weaver Company**FIRST REPORT**

Contractor

C NE NE

660 Ft. from N. Line Ft. from S. Line660 Ft. from E. Line Ft. from W. Line**SECTION PLAT**

			0

CHASE POOLLocation Rig up

Drilling and Remarks:

Rotary**RECORD**Cased in., ft.Sand Gas Oil Total Depth **PRODUCTION**1st 24 hrs. Nat. 1st 24 hrs. after shot Gas Cu. Ft.Dry Hole Abandoned

Date

FEB 10 1943 19S. J. LEWIS Scout

Rice

KANSAS

Map No. 49 Sec. 19 Twp. 19 R. 9WWell No. 3 Robins

C. H. Weaver

Company

COMPLETED

Contractor

C NE NE

SECTION PLAT

660 Ft. from N. Line

Ft. from S. Line

660 Ft. from E. Line

Ft. from W. Line

			o

CHASE POOL

Location

Rig up

Drilling and Remarks:

*Ar 83256**5" C 3256**Pump 500 Pst.**442 Gr*

RECORD

Cased _____ in., _____ ft.

Sand _____

Gas _____

Oil _____

Total Depth 3266

PRODUCTION

1st 24 hrs. Nat. _____

1st 24 hrs. after shot _____

Gas _____ Cu. Ft.

Dry Hole _____

Abandoned _____

Date

MAR 17 1943

19

S. J. LEWIS Scout