


Map No. KANSAS Sec. 6 Twp. 21 R. 3W

Well No. 1-506 Farm Spencer & Shue

Company Spencer & Shue

NORTH

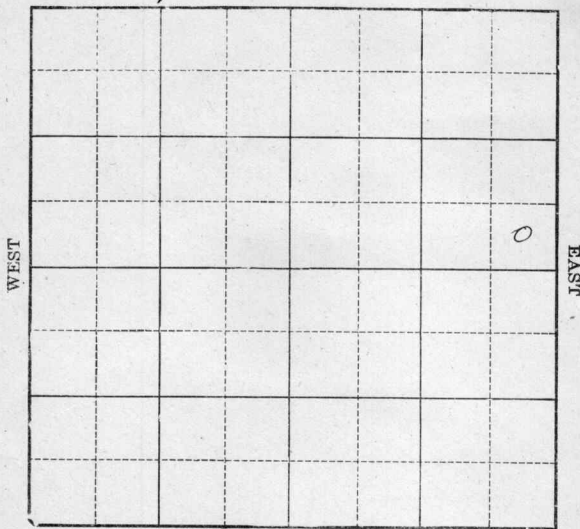

SOUTH

OWDD

Location _____

Drilling Remarks _____

Rig Up _____

Drilling Remarks _____

RECORD

Cased _____ in. _____ ft.

Sand _____

Gas _____

Oil _____

Total Depth _____

PRODUCTION

1st 24 hrs. Nat. _____

1st 24 hrs. after shot _____

Gas _____ cu. ft.

Dry Hole _____

Abandoned _____


Map No. KANSAS Sec. 16 Twp. 21 R. 3W
Well No. 1-Boehn Farm
Ritz O & S Company

 Ft. from N. Line

330 Ft. from S. Line

330 Ft. from E. Line

1931 Ft. from W. Line

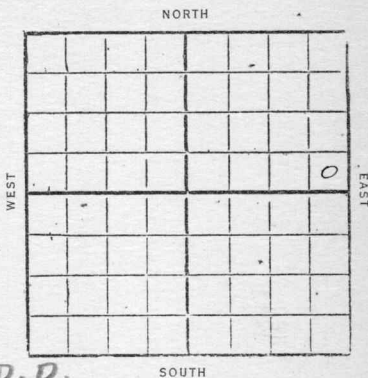

O.W.D.D.

Date REPORT

6/10	Loc
6/17	
6/24	Run up
7/1	drg 250'
7/8	" 1240'
7/15	
7/22	8"-2330
	Drlg 2460'
7/29	" 2680'
8/5	WIR 6"-3000'
8/12	Top Chat 3015
	T.D. 3019' Cem 6"
8/19	Chat 3015-74
	T.D. 3074
	Flow 360 gbl 24 hr
	Comp
1933	Lime 3144
11/8	Viola 3404
	Wilcox 3439 T.D. 3444 Water
	+ small show oil P.B. chat
	COMPLETED

KANSAS

Map No. 43 Sec. 16 Twp. 21 R. 3^W

Well No. 1 Koehn

Ritz Oil & Gas Company

Contractor

FIRST REPORTS

Ft. from N. Line

330 Ft. from S. Line

330 Ft. from E. Line

Ft. from W. Line

SECTION PLAT

			0

Location ✓

Rig up

Drilling and Remarks:

RECORD

Cased in., ft.

Sand

Gas

Oil

Total Depth

PRODUCTION

1st 24 hrs. Nat.

1st 24 hrs. after shot

Gas Cu. Ft.

Dry Hole

Abandoned

Date

JUN 1 0 1931

192

CHAS. L. SHERWOOD

Scout

Map No. KANSAS Sec. 16 Twp. 21 R. 3 W

Well No. 1 Koch

Ritz Oil & Gas Co Company

Contractor

COMPLETE

SECTION PLAT

			0

Ft. from N. Line

330 Ft. from S. Line

330 Ft. from E. Line

Ft. from W. Line

Location

Rig up

Drilling and Remarks:

Flow 360 Bbls.
24 hours.

RECORD

Cased 1 in., 3015-3074 ft.

Sand Chat 3015-3074

Gas

Oil

Total Depth 3074

PRODUCTION

1st 24 hrs. Nat.

1st 24 hrs. after shot

Gas 200 Cu. Ft.

Dry Hole

Abandoned

Date

AUG 19 1931

192

CHAS. L. SHERWOOD

Scout

Map No. 43 Sec. 16 Twp. 21 R. 3WWell No. 1-P KaehnSpencer T. Shell Company

FIRST REPORTS Contractor

COMPLETED

SECTION PLAT

			0

Ft. from N. Line

330 Ft. from S. Line330 Ft. from E. Line

Ft. from W. Line

Location

Rig up

Drilling and Remarks:

OTD 3078. Base
 L. 3144. Viola
 3404. Wilcox 3439
 TD 3444. Water
 and small show
 oil. P.B. to chert,
 where it was
 deepened from.

Date

11-8-33 192

RECORD

Cased.....in.,ft.

Sand.....

Gas.....

Oil.....

Total Depth.....

PRODUCTION

1st 24 hrs. Nat.....

1st 24 hrs. after shot.....

Gas.....Cu. Ft.

Dry Hole.....

Abandoned.....

O. Mannichuk Scout