


SECTION 12 TOWNSHIP 18 RANGE 1W

WELL NO. #1 Meier

COMPANY Westgate Oil

NORTH C S $\frac{1}{2}$ SW SW

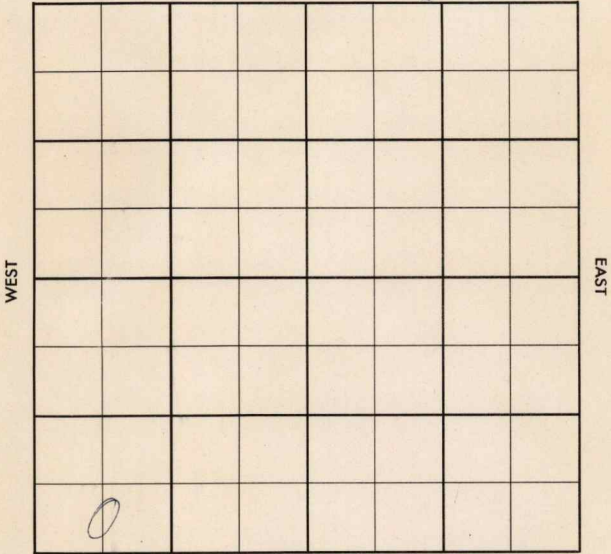

SOUTH

19-~~AM~~M
WILDCAT

FORM 513 SUNRAY

County McPherson Elev. _____
Sec. 12 Twp. 18 Rge. 1W
Company Westgate Oil
Farm Name Meier No. 1

TOPS	DEPTH	LOG	DATUM	Loc. in Sec.
Anh.				C S $\frac{1}{2}$ SW SW
Tr.				
H.				
Tr.				
Dg.				
Bl.				
L.				Geol. _____
K.C.				Contr. _____
B.K.C.				
Ce.				
C.				<u>Greenland</u>
M.				Pool
M.				<u>Wild cat</u>
K.				FIRST REPORT
Mz.				
Mo.				
V.				
S.				
S.				
A.				
R.				
PE.				
G.				
T.D.				

Date Comm. M I R

~~XXXXXXXXXX~~

Co.
Lse.
No.
Sec.
T.
R.

County McPherson Elev. 1507 RB
 Sec. 12 Twp. 18 Rge. 1W
 Company Westgate Oil
 Farm Name Meier No. 1

TOPS	DEPTH	LOG	DATUM	Loc. in Sec.
Anh.				C S $\frac{1}{2}$ SW SW
Tp.				
H.				
Tr.				
Dg.				
Bl.	<u>2182</u>			
L.	<u>2235</u>			Geol.
K.C.				Contr.
B.K.C.				<u>Greenland</u>
Ce.				Pool
C.				<u>Wildcat</u>
M. <u>L1</u>	<u>2809</u>			
M.				
K.				
Mz.				
Mo.				
V.				
S.				
S.				
A.				
R.				
PE.				
G.				
TD.	<u>2843</u>			

FEB 13 '57
ABANDONED

Date Comm. MIR FEB 13 '57 2-5-57 8578 160
1110

DEA