


Section 13 Township 18 Range 1W

Well No. #1 Bishop

Company Adair Morton etal.

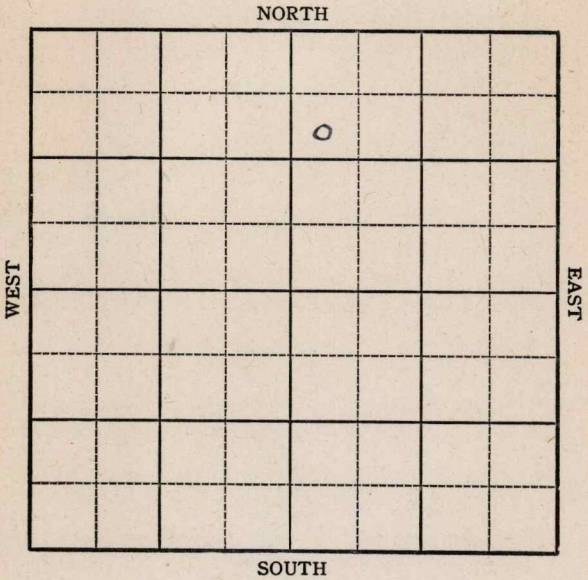

KANSAS

McPherson

Sec. 13 Twp. 18 R. 1-W

Well No. #1 Bishop Farm


Adair Morton etal Company

990 Ft. from N. Line

 Ft. from S. Line

 Ft. from E. Line

330 Ft. from W. Line

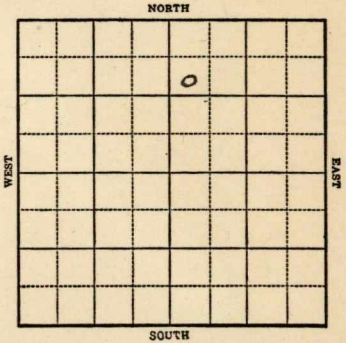

1944

R E P O R T

2/2

8" @ 154
Drlg. 1348'

2/9

Miss 2731
Viola 3264
TD 3270

ABANDONED

KANSAS
Map No. 42 Sec. 13 Twp. 18 R. 1W
Well No. 1 Bishop

Adair Morton et al. Company

FIRST REPORT Contractor
SW NW NE


SECTION PLAT

990 Ft. from N. Line

 Ft. from S. Line

 Ft. from E. Line

330 Ft. from W. Line

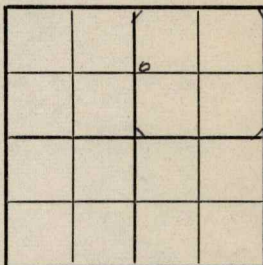

Baden Pool

Location

Rig up

Drilling and Remarks:

8" - 154

1348

RECORD

Cased in., ft.

Sand

Gas

Oil

Total Depth

PRODUCTION

1st 24 hrs. Nat.

1st 24 hrs. after shot

Gas Cu. Ft.

Dry Hole

Abandoned

Date

FEB 2 1944 19


S. J. LEWIS Scout

KANSASMap No. 42 Sec. 13 Twp. 18 R. 1WWell No. 1 BishopAdair & Morton etal. CompanyABANDONED

Contractor

SW NW NE

SECTION PLAT

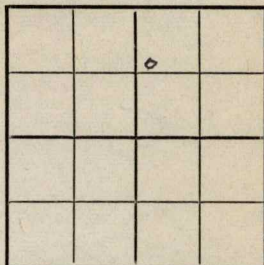990 Ft. from N. Line Ft. from S. Line Ft. from E. Line330 Ft. from W. LineBaden PoolLocation Rig up

Drilling and Remarks:

*Miss 2731**Vista 3264*

RECORD

Cased in., ft.Sand Gas Oil Total Depth 3270

PRODUCTION

1st 24 hrs. Nat. 1st 24 hrs. after shot Gas Cu. Ft.Dry Hole Abandoned

Date

FEB 9 1944 19S. J. LEWIS Scout