


Map No. **KANSAS** Sec. 16 Twp. 21 R. 3w

Well No. A-2 Roehm Farm
Shell Pet Corp Company

NORTH

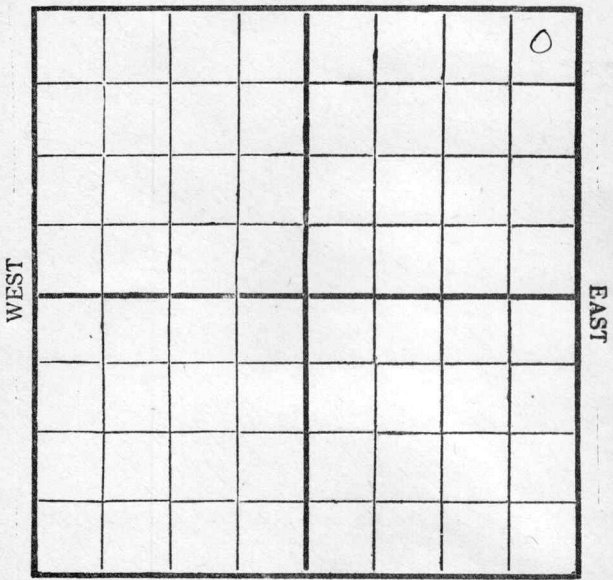

SOUTH

Location _____
Drilling Remarks _____

Rig Up _____
Drilling Remarks _____

RECORD


Cased _____ in. _____ ft.
Sand _____
Gas _____
Oil _____
Total Depth _____

PRODUCTION

1st 24 hrs. Nat. _____
1st 24 hrs. after shot _____
Gas _____ cu. ft. _____
Dry Hole _____
Abandoned _____

Map No. KANSAS Sec. 16 Twp. 21 R. 3^w
Well No. 2 - Koehn Farm
Shell Pet Company

330 Ft. from N. Line
_____ Ft. from S. Line
330 Ft. from E. Line
_____ Ft. from W. Line

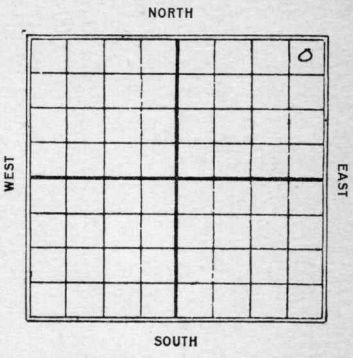

1930

Date	REPORT
3/5	Bldg mg (rotary)
3/12	1000 755
3/19	" 1050'
3/26	" 2803'
4/2	T. Chat 3072 Top Viola 3339 T.D - 3346 run 8"
4/9	Wilcox 3370-77 Swab 140 bbls 3 hrs.
4/16	T.D. 3377 Swab 725 bbls 24 hrs.
4/23	Viola 3339 Wilcox 3370-77 TD 3377
	swab 1025 bbl oil Corp.

Map No. KANSAS Sec. 16 Twp. 21 R. 3W

Well No. 2 Hoe

Shell Pet. Corp. Company

Contractor

SECTION PLAT

220 Ft. from N. Line

..... Ft. from S. Line

330 Ft. from E. Line

..... Ft. from W. Line

			0

FIRST REPORTS

Location.....

Rig up.....

Drilling and Remarks:

Rotary
Building rig

RECORD

Cased..... in., ft.

Sand.....

Gas.....

Oil.....

Total Depth.....

PRODUCTION

1st 24 hrs. Nat.....

1st 24 hrs. after shot.....

Gas..... Cu. Ft.

Dry Hole.....

Abandoned.....

Date

MAR 5 1930

192.....

S. J. LEWIS

Scout

Map No. *43* **KANSAS** Sec. *16* Twp. *21* R. *2W*

Well No. *2 Koehn*

Shell Pet. Corp. Company

Contractor

SECTION PLAT

			0

230 Ft. from N. Line

Ft. from S. Line

320 Ft. from E. Line

Ft. from W. Line

COMPLETED

Location

Rig up

Drilling and Remarks:

Vista 3339
Wilcox 3370-77

swab 1025 ft

RECORD

Cased in., ft.

Sand

Gas

Oil

Total Depth *3277*

PRODUCTION

1st 24 hrs. Nat.

1st 24 hrs. after shot

Gas Cu. Ft.

Dry Hole

Abandoned

Date

APR 23 1930

S. J. LEWIS Scout