


Section 19 Township 19 Range 9-W

Well No. #2 Robins

Company C. H. Weaver

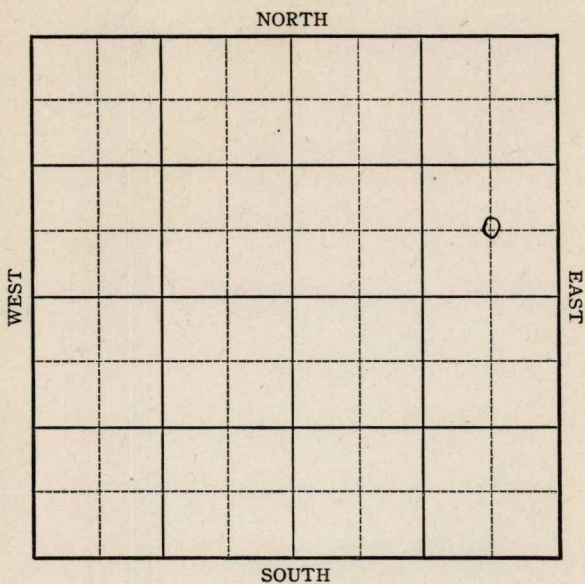

KANS.

Rice

Sec. 19 Twp. 19 R. 9-W

Well No. #2 Robins Farm

C. H. Weaver Company


Chase

 Ft. from N. Line

660 Ft. from S. Line

660 Ft. from E. Line

 Ft. from W. Line

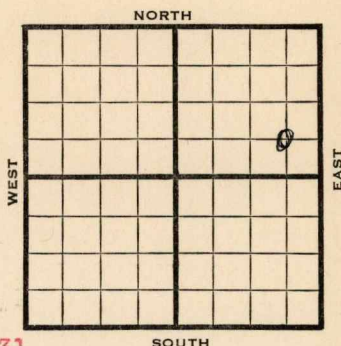

C SE NE **Elev. 1731**

1943 **REPORT**

1/27 8" Casing set 128'
Anhy 370'
Drlg. 1220'

2/3 Drlg. 2710'

2/10 **Topeka 2420**
Lans 2915 SO
Arb 3229 &

T.D. 3231' SO
5" @ 3230' RUST

2/17 TD 3249 500 acid.

2/24 Pump 250 oil in 16 hrs

3/3 " " " " " "

3/10 " " " " " "

3/17 " " " " " "

3/24 " " " " " "

3/31 " " " " " "

4/7 **Arb 3229'**
5" @ 3230'
1000 acid pump 450 pot.
Grav. 44
T.D. 3249'

COMPLETED

Rice

Map No. 49 Sec. 19 Twp. 19 R. 9WWell No. 2 RobinsC. H. Weaver

Company

FIRST REPORT

Contractor

C SE NE

SECTION PLAT

			o

 Ft. from N. Line660 Ft. from S. Line660 Ft. from E. Line Ft. from W. Line

CHASE POOL

Location Rig up

Drilling and Remarks:

8"-128'

Anhy. 370'

Drlg. 1220'

RECORD

Cased in., ft.Sand Gas Oil Total Depth

PRODUCTION

1st 24 hrs. Nat. 1st 24 hrs. after shot Gas Cu. Ft.Dry Hole Abandoned

Date

JAN 27 1943 19S. J. LEWIS Scout


Rice

KANSAS

Map No. 49 Sec. 19 Twp. 19 R. 9WWell No. 2 RobinsC. H. Weaver CompanyCOMPLETED Contractor

C S E N E

SECTION PLAT

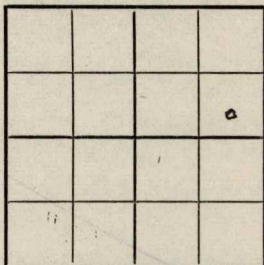 Ft. from N. Line660 Ft. from S. Line660 Ft. from E. Line Ft. from W. Line

CHASE POOL

Location Rig up

Drilling and Remarks:

*Ar 83229**5" @ 3230**1000 acid**Pump 450 B.Y.**44° S*

RECORD

Cased in., ft.Sand Gas Oil Total Depth 3249

PRODUCTION

1st 24 hrs. Nat. 1st 24 hrs. after shot Gas Cu. Ft.Dry Hole Abandoned

Date

APR 7 1943

19

S. J. LEWIS

Scout