

M. O. Peterson

Form 252-A
5M 4-32 MPC

Map No. KANSAS Sec. 16 Twp 21 R. 3^w

Well No. 2 Edgier Farm

Mylius etal Company


_____ Ft. from N. Line

990 Ft. from S. Line

125 Ft. from E. Line

_____ Ft. from W. Line

1933

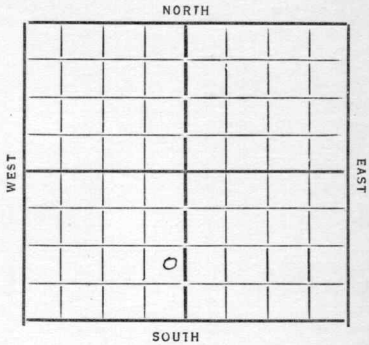

Date

REPORT

2/15	Flush pond
2/22	
3/14	
3/18	
3/15	material
3/22	Bldg Rig
3/29	Rigging up
4/4	12"-185' bldg 250
4/12	dly 2415'
4/19	" 2917'
4/26	Top Chat 3015 Cement 6" 3348 RUDT
5/4	Viola 3337-49 Rest
5/10	Base line 2080 Viola 3337-62 6" 3348 dly 3377 small show oil
5/17	Testing
5/24	Sand 3436-3444 pump + flow 1415 bbls 24 hours (Completed)

McPherson W

43 **KANSAS** Map No. Sec. 16 Twp. 21 R. 3

Well No. 2 *Ediger*

Mylius & Co Company

Contractor

FIRST REPORTS

SECTION PLAT

..... Ft. from N. Line

990 Ft. from S. Line

125 Ft. from E. Line

..... Ft. from W. Line

Location.....

Rig up.....

Drilling and Remarks:

Show Prod

RECORD

Cased..... in., ft.

Sand.....

Gas.....

Oil.....

Total Depth.....

PRODUCTION

1st 24 hrs. Nat.....

1st 24 hrs. after shot.....

Gas..... Cu. Ft.

Dry Hole.....

Abandoned.....

Date

FEB 15 1933

CHAS. L. SHERWOOD

..... 192..... Scout

McPherson

43 **KANSAS** Map No. _____ Sec. 16 Twp. 21 R. 3^W

Well No. 2 *Edger*

Mylius Co Company

Contractor

SECTION PLAT

COMPLETED

.....Ft. from N. Line

990 Ft. from S. Line

125 Ft. from E. Line

.....Ft. from W. Line

Location.....

Rig up.....

Drilling and Remarks:

*Pump flow
14 15 Res
24 hours*

RECORD

Cased.....in.,ft.

Sand *5.11 3436-3444*

Gas.....

Oil.....

Total Depth *3444*

PRODUCTION

1st 24 hrs. Nat.....

1st 24 hrs. after shot.....

Gas.....Cu. Ft.

Dry Hole.....

Abandoned.....

Date

MAY 2 4 1933

CHAS. L. SHERWOOD

192

Scout