


O. W. D. D.

Mc Pherson

Form 51—5M—5-34—Palace

Map No. KANSAS Sec. 16 Twp. 21 R. 3WWell No. 3 Kachin FarmShell Pet. Company

NORTH

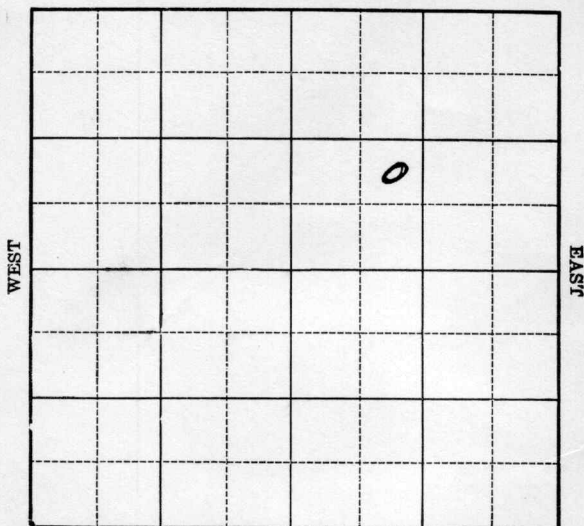

SOUTH

Location _____

Drilling Remarks _____

Rig Up _____

Drilling Remarks _____

RECORD

Cased _____ in. _____ ft.

Sand _____

Gas _____

Oil _____

Total Depth _____

PRODUCTION

1st 24 hrs. Nat. _____

1st 24 hrs. after shot _____

Gas _____ cu. ft.

Dry Hole _____

Abandoned _____


O. W. D. D.

McPherson

Map No. Sec. 16 Twp. 21 R. 3WWell No. 3 Kocher FarmShell Pet.

Company

NORTH

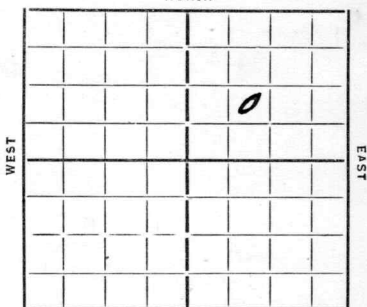

WEST

EAST

SOUTH

Ft. from N. Line

990

Ft. from S. Line

Ft. from E. Line

990

Ft. from W. Line

Date

REPORT

1934 -
12/12 Bldg. Rig
12/21 Rig
12/27 130 194 WOC
1/3/35 Bldg 1413
1/10 " 2410
1/17 " 3078 Chat 3000
1/24
1/31 Viola 3348 7" 3350 Bldg 3359
2/7 Wilcox 3386 Pay 3395-3406
T 7 3410 15 gts C.O.
2/14 Swab 47 oil 14 hrs.
25 gts 3394-3404
2/21 Tubing
2/27 Wx 3386 oil 3395-3406
T 7 3410 271 Bbls.

COMPLETED

OVER

1952

4/2

O. W. D. D

V 3348' Simp sh 3379'
Simp. sd. 3386' OTD 3410'
7" @ 3350' Was Simp. Prod.
RUST DP CO to 3410'
Arb. 3450' TD 3452' 4" @ 3451'
Bailing

4/9

Drlg. P

4/16

Oil Well TD 3452
Viola 3348 Simp. sh 3379
Simp. sd 3386
OTD 3410 7" @ 3350 CO to 3410
Arb. 3450 DD 3452 4" @ 3451
Comp. 41 bopd 189 bw

COMPLETED

Map No. 43 Sec. 16 Twp. 21 R. 3W

Well No. 3- Kuhn

Shell pit Company

Contractor

FIRST REPORT

SECTION PLAT

Ft. from N. Line

990 Ft. from S. Line

Ft. from E. Line

990 Ft. from W. Line

		0	

Location

Rig up

Drilling and Remarks:

Beck Rig

RECORD

Cased in., ft.

Sand

Gas

Oil

Total Depth

PRODUCTION

1st 24 hrs. Nat.

1st 24 hrs. after shot

Gas Cu. Ft.

Dry Hole

Abandoned

Date

12-12-37 192

ORVAL MANNSCHRECK Scout

Map No. 43 Sec. 16 Twp. 21 R. 3WWell No. 3-KrehnShell pit Company

Contractor

COMPLETED

SECTION PLAT

		0	

Ft. from N. Line

990 Ft. from S. Line

Ft. from E. Line

990 Ft. from W. Line

Location

Rig up

Drilling and Remarks:

RECORD

Cased _____ in., _____ ft.
 Sand Wilcox 3386
 Gas _____
 Oil 3395-3406
 Total Depth 3410

PRODUCTION

1st 24 hrs. Nat. _____
 1st 24 hrs. after shot _____
 Gas _____ Cu. Ft.
 Dry Hole _____
 Abandoned _____

Date

2-27-35 192

ORVAL MANNSCHRECK Scout

County **McPherson** State **Kansas**
Sec. **16** (Blk. Twp.) **21** (Sur. Rge.) **3W** Map No.
Operator **Shell**
Well No. **3** Farm **P. A. Koehn**
Elev. Location **NE SW NE**

FIRST REPORT

990 Ft. From **S** Line **NE**
990 Ft. From **W** Line Quarter

1st. Report **APR 2 1952**

Completion

Remarks **OWDD**

O. W. D. D.

Spudding Date

Drlg. Data

V 3348 Simp shale 3379 Simp sd. 3386
OTD 3410 7" @ 3350 was Simp prod.
Rust DP CO to 3410 Arb. 3450 TD 3452
4" @ 3451 Bailing

J. G. McGEHEE

O. W. D. D.

County **McPherson** State **Kansas**

Sec. 16 (Blk.) 21 (Sur.) 3W Map No.

Operator **Shell**

Well No. 3 Farm P. A. Koehn

Elev.	Location	NE	SW	NE

990 Ft. From S Line NE

990 Ft. From W Line Quarter

1st. Report

Completion **APR 16 1952**

Remarks (OWDD)

O. W. D. D.

Spudding Date _____

Drilg. Data Oil well TD 3452

Viola 3348	Simp. sh. 3379	Simp.sd.3386
------------	----------------	--------------

OTD 3410 7" @ 3350 CO to 3410

Arb. 3450 DD 3452 4" @ 3451

Comp. 41 bopd 189 bw

J. G. McGEHEE