
FORM 51 25M 8-50 WESTERN McPherson KANSAS

Section 13 Township 18 Range 1 W

Well No. # 3 Ruth

Company Westgate-Greenland

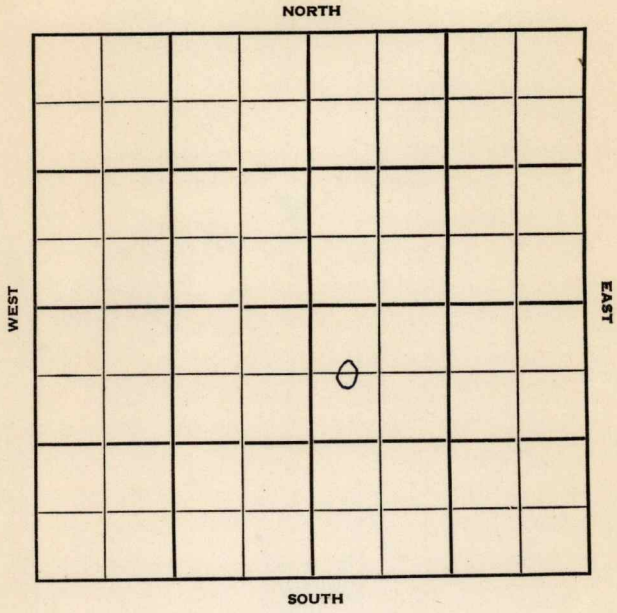

FORM 252-B
10M 11-50 PETROL

McPherson

KANSAS

Sec. 13 Twp. 18 R. 1W

Well No. #3 Ruth Farm

Westgate-Greenland Company

Mallard Drlg.- Contr. Contractor

Battle Hill Pool


660' Ft. from N. Line

_____ Ft. from S. Line

_____ Ft. from E. Line

330' Ft. from W. Line

C W L NW SE

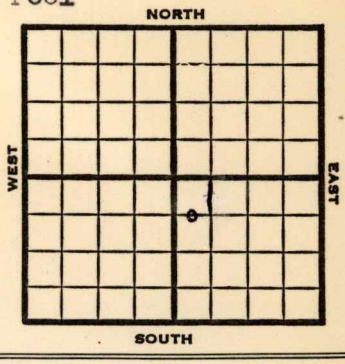

1951	Elev. 1499' REPORT
4/25	Spud 4-21-51 8" @ 125 Drlg. 800'
8/8	Spud 4-21-51 Oil Well TD 2868 8" @ 125 Miss 2800-68 5" @ 2850 60/2800-20 FU 1000' oil 400' wtr 12 hr. S/20 bo 6 hr. Comp. 40 bopd

COMPLETED

FORM 275 FOR SALE BY KANSAS BLUE PRINT CO.

County McPherson State Kansas

Sec. 13 (Blk. Twp.) 18 (Sur. Rge.) 1W Map No.

Operator Westgate-Greenland

Well No. 3 Farm Ruth

Elev. Location C W L NW SE



660 Ft. From N Line SE

330 Ft. From W Line Quarter

1st. Report APR 25 1951

Completion

Remarks Mallard Drlg. - Contr.

Spudding Date 4-21-51

Drlg. Data Battle Hill Pool

8" @ 125 drlg. 800

J. E. TYRA

FORM 275 FOR SALE BY KANSAS BLUE PRINT CO.

County McPherson State Kansas

Sec. 13 (Blk. Twp.) 18 (Sur. Rge.) 1W Map No.

Operator Westgate-Greenland

Well No. 3 Farm Ruth

Elev. 1499 Location C W L NW SE



660 Ft. From N Line SE

330 Ft. From W Line Quarter

1st. Report

Completion AUG 8 1951

Remarks Battle Hill Pool
Mallard Drlg. - Contr.

Spudding Date 4-21-51

Drlg. Data Oil well TD 2868

8" @ 125 Miss. 2800-68 5" @ 2850

60/ 2800-20 FU 1000' oil 400' water

12 hr. S/ 20 bo 6 hr.

Comp. 40 bopd

J. E. TYRA