

McPherson


Form 51-5M-11-31-Palace

Map No. KANSAS Sec. 16 Twp. 21 R. 3rd

Well No. #1-A Newfield Farm

Spencer & Shell Company

NORTH

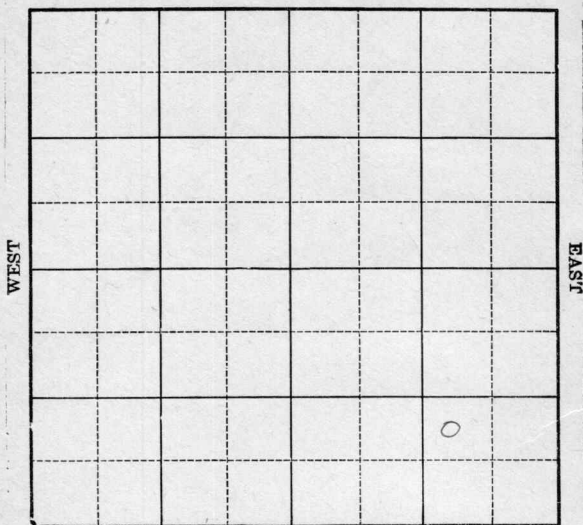

SOUTH

Location

Drilling Remarks

Rig Up

Drilling Remarks

RECORD

Cased in. ft.

Sand

Gas

Oil

Total Depth

PRODUCTION

1st 24 hrs. Nat.

1st 24 hrs. after shot

Gas cu. ft.

Dry Hole

Abandoned


Map No. KANSAS Sec. 16 Twp. 21 R. 3^w
Well No. #1-R Newfield Farm
Spencer & Shell Company

_____ Ft. from N. Line

990 Ft. from S. Line

990 Ft. from E. Line

_____ Ft. from W. Line

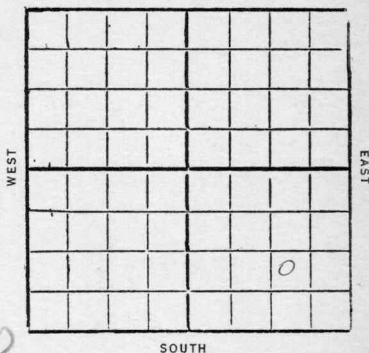

1932

OWDD

Date REPORT

8/31	Pos
9/7	Regn up
9/14	15" 276
	Reg 1035
9/21	12" 1640
	Reg 1880
9/30	HFV 1885
	10" 1889
	Reg 2340'
10/5	" 2560'
10/12	8" 2557
	Reg 2950'
10/19	Top Chat 3031
	Show gas 3075
	" Oil 3096
10/26	TD 3100
	Flow 200 bbl 12 hrs
11/2	Chat 3031-3100
	Show gas 3075
	" Oil 3096
	TD 3100'
	Flow 190 bbl 24 hr
	Est 3 rd gas

1933

OW. DD

4/5 - Rigging up to deepen

4/12 drlg 3230'

4/19 B. L. 3158' L. 10. 3230'

4/26 Cement 6" 3230'

5/4 Tap Violas 3413 Wilcox 3452-60
shot 15 gts 3452-62 swab 4 to 5
bbls per hr

5/10 pumping 150 bbls per day

5/17 —

5/24 - Wilcox 3452-60

shot 15 gts 3452-60

Pump 150 bbls

(Completed)

43 KANSAS Map No. Sec. 16 Twp. 21 R. 3 W

Well No. 1 Newplat

Spencer & Shell Company

Contractor

FIRST REPORTS

Ft. from N. Line

990 Ft. from S. Line

990 Ft. from E. Line

Ft. from W. Line

SECTION PLAT

			0

Location

Rig up

Drilling and Remarks:

R.O.Y.

RECORD

Cased in., ft.

Sand

Gas

Oil

Total Depth

PRODUCTION

1st 24 hrs. Nat.

1st 24 hrs. after shot

Gas Cu. Ft.

Dry Hole

Abandoned

Date

192 Scout

43 KANSAS

Map No. _____ Sec. 16 Twp. 21 R. 3 W

Well No. A-1 Newell

Spencer & Shree Company

Contractor

CORRECTION

SECTION PLAT

			o

_____ Ft. from N. Line

990 _____ Ft. from S. Line

990 _____ Ft. from E. Line

_____ Ft. from W. Line

Location _____

Rig up _____

Drilling and Remarks:

RECORD

Cased _____ in., _____ ft.

Sand _____

Gas _____

Oil _____

Total Depth _____

PRODUCTION

1st 24 hrs. Nat. _____

1st 24 hrs. after shot _____

Gas _____ Cu. Ft.

Dry Hole _____

Abandoned _____

Date

SEP 14 1932 CHAS. L. SHERWOOD Scout

Change well number to above.

43 KANSAS

Map No. _____ Sec. 16 Twp. 21 R. 3

Well No. H-1 *Henrietta*
Spencer & Sheel Company

Contractor

COMPLETED

SECTION PLAT

_____ Ft. from N. Line

990 Ft. from S. Line

990 Ft. from E. Line

_____ Ft. from W. Line

Location _____

Rig up _____

Drilling and Remarks:

Show gas 3075

" Oil 3096

Flow 190 bbls

24 Hours.

RECORD

Cased _____ in., _____ ft.

Sand _____ *that 30.31-3100*

Gas _____

Oil _____

Total Depth *3100*

PRODUCTION

1st 24 hrs. Nat. _____

1st 24 hrs. after shot _____

Gas *657 3 m* Cu. Ft.

Dry Hole _____

Abandoned _____

Date

NOV 2 1932 CHAS. L. SHERWOOD

192

Scout

43 *McPherson*

W

Map No. *11a* **KANSAS** Sec. *16* Twp. *21* R. *3*Well No. *1* *Henrietta**Spencer & Shree* Company

Contractor

FIRST REPORTS

SECTION PLAT

Ft. from N. Line

990 Ft. from S. Line*990* Ft. from E. Line

Ft. from W. Line

<i>11</i>			<i>11</i>
<i>0</i>	<i>11</i>	<i>0</i>	
			<i>0</i>

Location

Rig up

Drilling and Remarks:

also
Rigging up
to Deepen

RECORD

Cased *Chas* in, *3031-3100* ft.
 Sand
 Gas
 Oil
 Total Depth *3100*

PRODUCTION

1st 24 hrs. Nat.
 1st 24 hrs. after shot
 Gas Cu. Ft.
 Dry Hole
 Abandoned

Date

APR 5 1933 *192* **CHAS. L. SHERWOOD** Scout

McPherson
 43 KANSAS
 Map No. 16 Sec. 16 Twp. 21 R. 3
 Well No. 1 "4" Newplat
 Spencer & Dhee Company
 Contractor

COMPLETED

SECTION PLAT

			0

Ft. from N. Line

990 Ft. from S. Line

990 Ft. from E. Line

Ft. from W. Line

Location

Rig up

Drilling and Remarks:

Dhat 15/3452-60

Pump 150 Bbl

RECORD

Cased in., ft.

Sand 1100 x 3452-60

Gas

Oil

Total Depth 3460

PRODUCTION

1st 24 hrs. Nat.

1st 24 hrs. after shot

Gas Cu. Ft.

Dry Hole

Abandoned

Date

MAY 24 1933 CHAS. L. SHERWOOD

192

Scout