

KANSAS

McPherson

Section 15 Township 18 Range 1WWell No. #2 SchulzCompany Anderson Prichard

NORTH

4

0							

SOUTH

WEST

EAST


KANSAS

McPherson

Sec. 15 Twp. 18 R. 1-W

Well No. #2 Schulz Farm
Anderson Prichard Company

NORTH

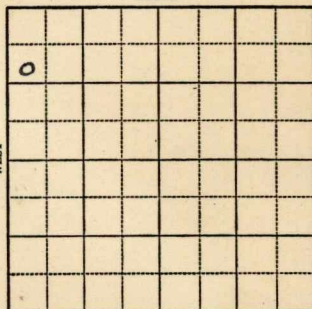

990 Ft. from N. Line

Ft. from S. Line

Ft. from E. Line

330 Ft. from W. Line

elev. 1390

R E P O R T

1944

2/2 Location.

2/8 "

2/15 Rotary

2/23 8" @ 191
Drlg. 1640

3/1 Cong 2689
Miss 2695
TD 2697
5" @ 2696
Rust

3/8 TD 2709-2000 acid
Swb 9½ oil per hr 9 hrs

3/16 " " " " " "

3/22 " " " " "

3/29 " " " "

4/5 5" @ 2696
Miss 2696
TD 2709
2000 acid
Pump 24½ oil
Gravity 36.8

COMPLETED


KANSAS
Map No. 42 Sec. 15 Twp. 18 R. 1W
Well No. 2 Schulz

Anderson Prichard Company

FIRST REPORT Contractor

SW NW NW

SECTION PLAT

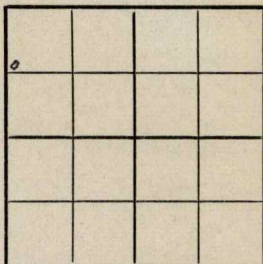

990 Ft. from N. Line

_____ Ft. from S. Line

_____ Ft. from E. Line

330 Ft. from W. Line

Baden Pool

Location X

Rig up _____

Drilling and Remarks:

RECORD

Cased _____ in., _____ ft.

Sand _____

Gas _____

Oil _____

Total Depth _____

PRODUCTION

1st 24 hrs. Nat. _____

1st 24 hrs. after shot _____

Gas _____ Cu. Ft.

Dry Hole _____

Abandoned _____

Date

FEB 2 1944 19

S. J. LEWIS Scout

Map No. 42 Sec. 15 Twp. 18 R. 1W
 Well No. 2 Schulz

Anderson & Prichard Company

COMPLETED Contractor

SW NW NW

SECTION PLAT

0			

990 Ft. from N. Line

_____ Ft. from S. Line

_____ Ft. from E. Line

330 Ft. from W. Line

Baden Pool

Location _____

Rig up _____

Drilling and Remarks:

*Miss 2695
 5" C 2696
 2000 acid
 Pump 242 P & S*

365 ft

RECORD

Cased _____ in., _____ ft.

Sand _____

Gas _____

Oil _____

Total Depth 2709

PRODUCTION

1st 24 hrs. Nat. _____

1st 24 hrs. after shot _____

Gas _____ Cu. Ft.

Dry Hole _____

Abandoned _____

Date

APR 5 1944 19

S. J. LEWIS Scout