


KANSAS
Mcpherson

FORM 51 5M 10-41 PETROL

Section 16 Township 21 Range 3-W

Well No. 5 Koehn

Company Shell

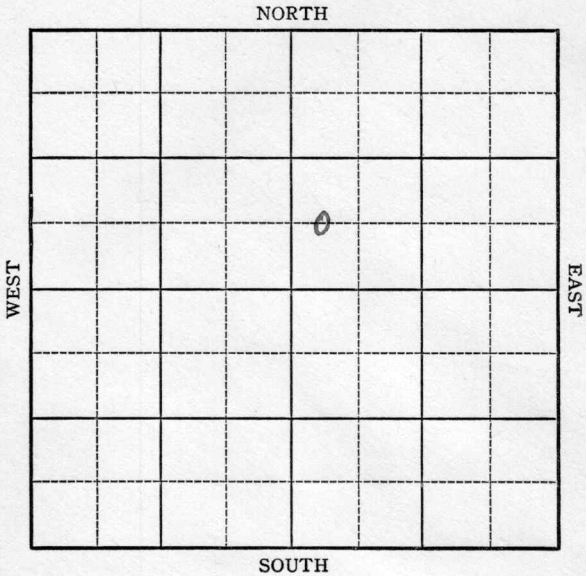

KANSAS

McPherson

Sec. 16 Twp. 21 R. 3-W

Well No. #5 Koehn Farm

Shell Company

(Voshell)


 Ft. from N. Line

660 Ft. from S. Line

 Ft. from E. Line

330 Ft. from W. Line

Elev. 1464

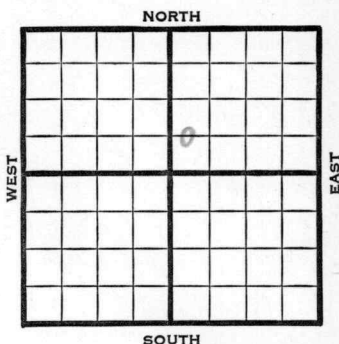

1941	REPORT
11/12	Cellar.
11/20	8" - 162' Drlg. 1985'
11/28	Lans. 2408' Drlg. 2996'
12/4	Miss. 2995' Kind. 3076'
	Viola 3330' 4" - 3332'
	Drlg. 3344'
12/11	TD. 3380
	Simp. Sd. 3358
	10 qts. 3368-78 swb. 37 oil in
	8 hrs. C. O.
12/18	" " " " "
12/24	Pump 162 oil 24 hours.
12/30	Viola 3330
	4" @ 3332
	Simpson SD 3358
	10 Qts. 3368-78
	TD 3380
	Pump 138 Potential.
	42.0 Grav.
	COMPLETED

McPherson **KANSAS**Map No. 11-43 Sec. 16 Twp. 21 R. 3WWell No. 5 KoehnShell CompanyFIRST REPORT Contractor

C WL SW NE

SECTION PLAT

		o	

 Ft. from N. Line660 Ft. from S. Line Ft. from E. Line330 Ft. from W. LineVOSHELL POOLLocation Rig up

Drilling and Remarks:

Cellar

RECORD

Cased in., ft.Sand Gas Oil Total Depth

PRODUCTION

1st 24 hrs. Nat. 1st 24 hrs. after shot Gas Cu. Ft.Dry Hole Abandoned

Date

S. J. LEWIS

NOV 12 1941

Scout

Map No. 43 Sec. 16 Twp. 21 R. 3WWell No. 5 KoehnShell CompanyCOMPLETED Contractor

C WL SW NE

_____ Ft. from N. Line

660 Ft. from S. Line

_____ Ft. from E. Line

330 Ft. from W. Line

SECTION PLAT

		0	

VOSHELL POOL

Location _____

Rig up _____

Drilling and Remarks:

*Viola 3330**4" @ 3332**Simpson Sub 3358**10g to 3368-78**Pump. 138 P.V.**420 Gr*

RECORD

Cased _____ in., _____ ft.

Sand _____

Gas _____

Oil _____

Total Depth 3380

PRODUCTION

1st 24 hrs. Nat. _____

1st 24 hrs. after shot _____

Gas _____ Cu. Ft.

Dry Hole _____

Abandoned _____

Date

DEC 30 1941

19

S. J. LEWIS

Scout