


Section 15 Township 18 Range 1W  
 Well No. #1 Schultz (Shultz)  
 Company Bennett & Roberts ?

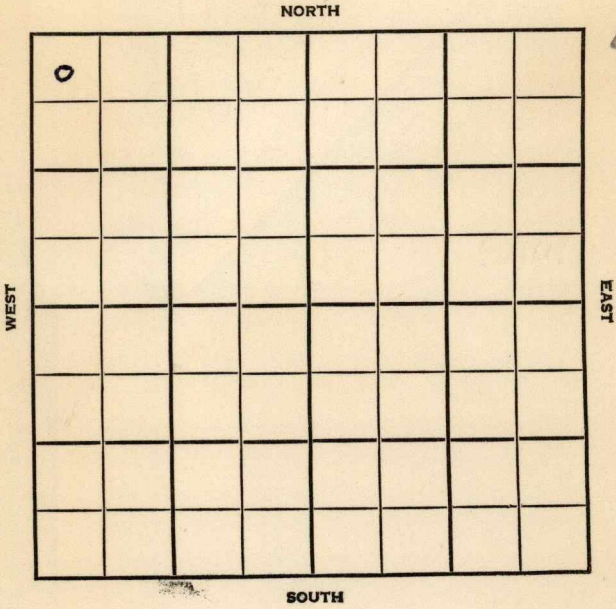

SEC.	TWP.	R.
15	18	1W

WELL NO. 1 Schultz FARM

COMPANY Bennett & Roberts

CONTRACTOR Co. Tools


Paden Pool

330 Ft. from N. Line

Ft. from S. Line

Ft. from E. Line

330 Ft. from W. Line

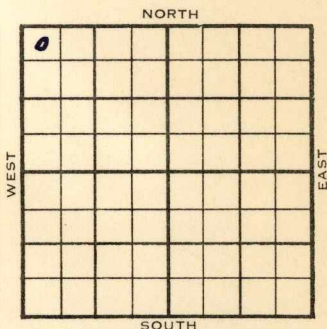

NW NW NW

1955	ELEVATION	REPORT
	1384	

4/13 Spud 4-10-55  
8" @ 163'  
Drlg. 540'

5/25 Miss 2691; TD 2777; 8" 162; 5 1/2" 2770;  
500 A; swb 2 bo plus 4 bwph; pmp 21  
bopd plus 62% wtr from Miss

**COMPLETED**

County **McPherson** State **Kansas**  
 Sec. **15** (Blk. **18** (Sur. **1W** Map No.  
 (Twp.) (Rge.)  
 Operator **Bennett & Roberts**  
 Well No. **1** Farm **Schultz**  
 Elev. Location **NW NW NW**

0				

**330** Ft. From **N** Line **NW**  
**330** Ft. From **W** Line Quarter  
 1st. Report **APR 13 1955**  
 Completion  
 Remarks  
**Co. tools**  
 Spudding Date **4-10-55**

Drlg. Data **Paden Pool**  
**8" @ 163 drlg. 540**