

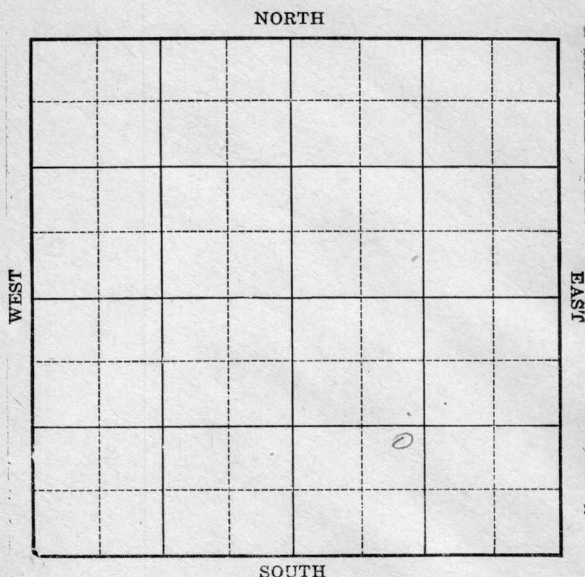
McPherson

KANSAS

Form 51-5M-11-31-Palace

Map No. _____ Sec. 16 Twp. 21 R. 3W

Well No. 3-A Neufeldt Farm
Spencer + Shell Company



Location _____

Drilling Remarks _____

Rig Up _____

Drilling Remarks _____

RECORD

Cased _____ in. _____ ft.

Sand _____

Gas _____

Oil _____

Total Depth _____

PRODUCTION

1st 24 hrs. Nat. _____

1st 24 hrs. after shot _____

Gas _____ cu. ft.

Dry Hole _____

Abandoned _____

McPherson

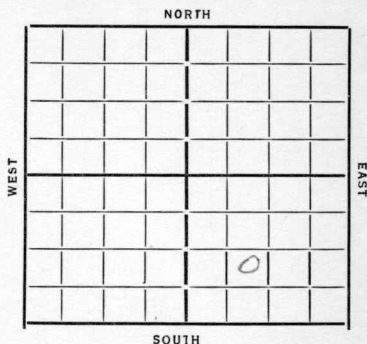
KANSAS

Form 252-A
5M 4-32 MPCMap No. _____ Sec. 16 Twp. 21 R. 3WWell No. 3-A Newfeldt Farm
Spencer + Shell Company

_____ Ft. from N. Line

990 Ft. from S. Line

_____ Ft. from E. Line

990 Ft. from W. Line

Date

REPORT

19337/19 Location7/26 Cellar8/2 —8/9 —8/17 —8/23 —8/30 —9/6 —9/13 —9/20 —9/29 —10/5 —10/11 —10/18 —10/25 —11/1 —11/8 —11/15 —11/22 Tools.11/29 Rigging12/6 —12/13 dlg 120-12/21 20" 156 15" at 26412/27 Arleg 9651/11 12" at 1736 - Arleg 19671/17 Arleg 2345 - H.F.W at 21701/24 " 2460

1/31 Arly 2460

2/7 — 2/14 — 2/23 — 3/1 —

3/8 Arly 2700 247 26 2525

3/15 Chat 3028 S.O. 3068
Run 6"

3/22 Viola 3405 24R6"

3/29 5" 3405 240C

4/5 Simpson 3430 shot 10
gte 3433-43 P.B.P.

4/12 Pump 125 BBl 10 hrs.

4/19 —

4/25 Simpson 3430 T.D. 3443
471 BBl,

COMPLETED

Map No. 43 Sec. 16 Twp. 21 R. 3WWell No. 3A NeufeldtSpencer & Shell Company

Contractor

SECTION PLAT

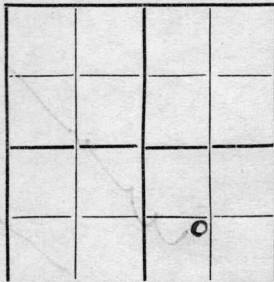
Ft. from N. Line

990 Ft. from S. Line

Ft. from E. Line

990 Ft. from W. Line

FIRST REPORTS

Location ✓

Rig up

Drilling and Remarks:

RECORD

Cased.....in.,ft.

Sand.....

Gas.....

Oil.....

Total Depth.....

PRODUCTION

1st 24 hrs. Nat.....

1st 24 hrs. after shot.....

Gas.....Cu. Ft.

Dry Hole.....

Abandoned.....

Date

7/19/33 192. Oval Mannichree Scout

Map No. 43 Sec. 16 Twp. 21 R. 3WWell No. 3-A-NewfieldSpencer & Shell Company

Contractor

COMPLETED

SECTION PLAT

		0	

_____ Ft. from N. Line

990 Ft. from S. Line

_____ Ft. from E. Line

990 Ft. from W. Line

Location _____

Rig up _____

Drilling and Remarks:

471 lbs

RECORD

Cased _____ in., _____ ft.

Sand Spencer 3430

Gas _____

Oil _____

Total Depth 3443

PRODUCTION

1st 24 hrs. Nat. _____

1st 24 hrs. after shot _____

Gas _____ Cu. Ft.

Dry Hole _____

Abandoned _____

Date

4-25-34 19

ORVAL MANNING Scout