

Anderson


McPherson County

FORM 51 5M 6-46 PETROL

Section 15 Township 18 Range 1W

Well No. #6 Schulz

Company Anderson & Prichard

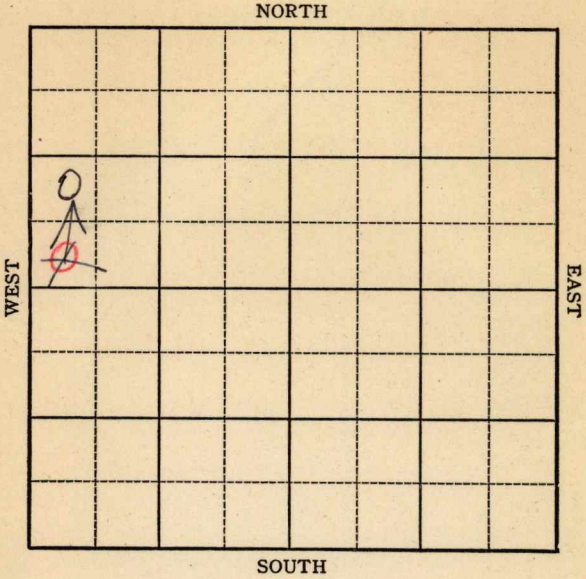

Sec. 15 Twp. 18 R. 1W

Well No. #6 Schulz Farm

Anderson & Prichard Company

Battle Hill

Ft. from N. Line

880

Ft. from S. Line


330 330

Ft. from E. Line

Ft. from W. Line

330

SW NW

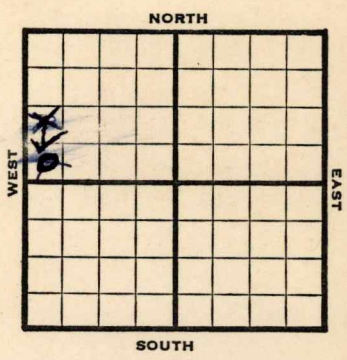

1946 ~~1397~~ E. 140' REPORT

- 7/17 RUR
- 7/23 8" @ 180
Drlg 1345'
- 7/30 Miss 2708
Drlg 2837
- 8/6 Viola 3185
TD 3189
5" @ 3185-500 acid
swb 25 oil in 6 hrs
- 8/13 " " "
- 8/20 " " "
- 8/28 Viola 3185'
5" @ 3185'
TD 3189'
500 Acid
Pump 198 Pot
36 Grav.

COMPLETED

KANSAS

Kansas Pool Name Battle Hill

Map No. 42 Sec. 15 Twp. 18 R. 1W

Well No. 6 Schulz

Anderson & Prichard Company

FIRST REPORT Contractor

SW NW

SECTION PLAT

 Ft. from N. Line

330 Ft. from S. Line

 Ft. from E. Line

330 Ft. from W. Line

o			

McPherson County

Location

Rig up

Drilling and Remarks:

RUR

RECORD

Cased in., ft.

Sand

Gas

Oil

Total Depth

PRODUCTION

1st 24 hrs. Nat.

1st 24 hrs. after shot

Gas Cu. Ft.

Dry Hole

Abandoned

Date

JUL 17 1946

19

S. J. LEWIS

Scout

